




# Weyerhaeuser Co.; Aurora Forest Nursery - Transfer Application - 72472 IR

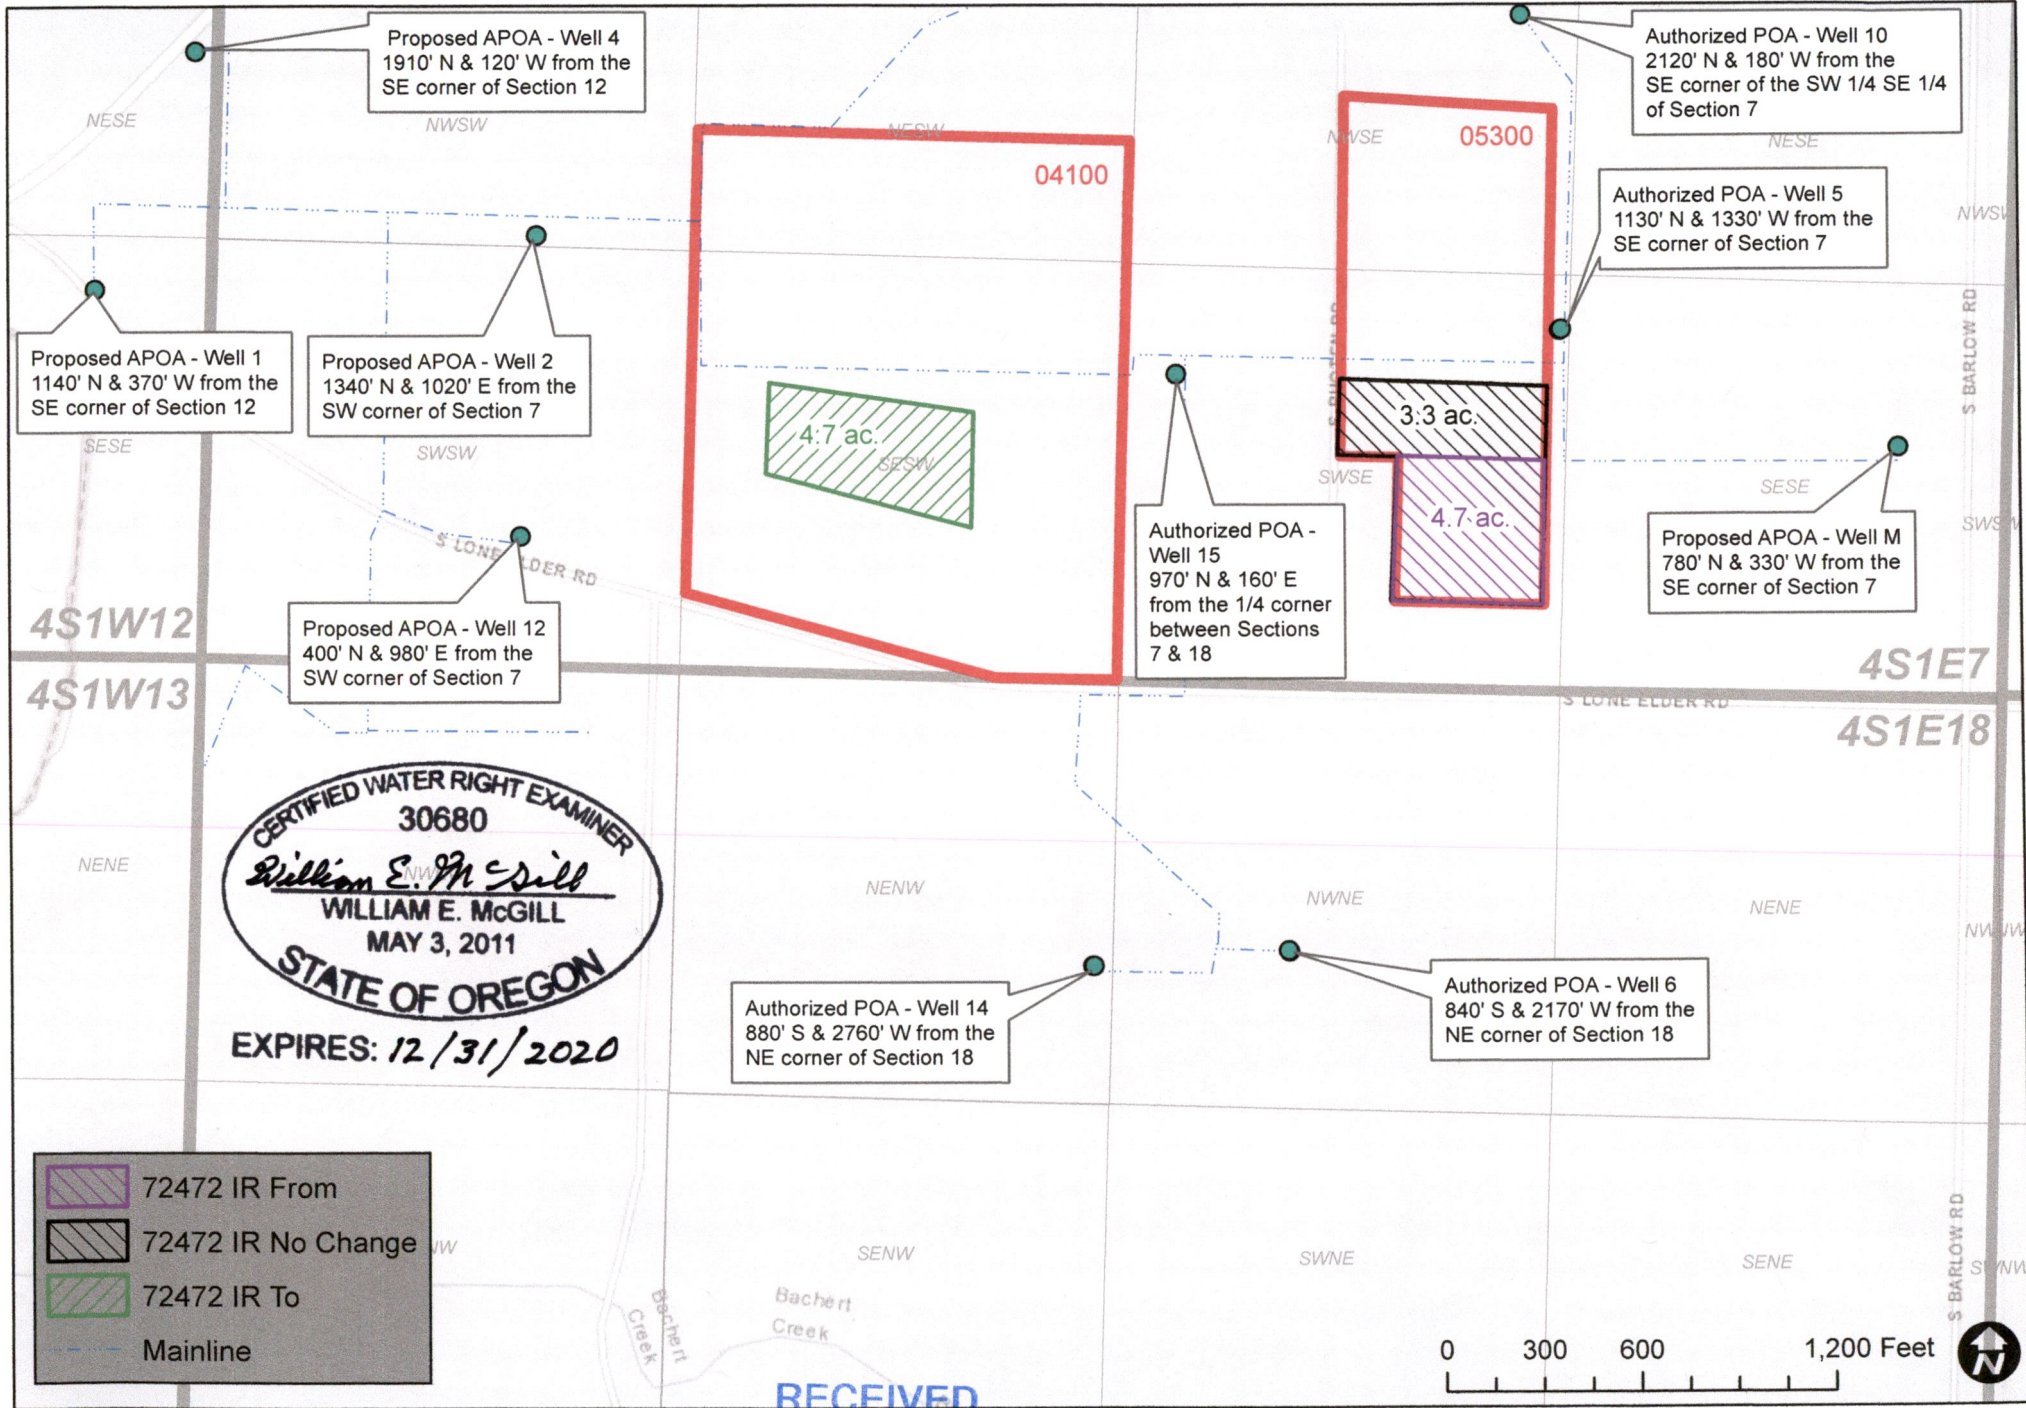

CERTIFIED WATER RIGHT EXAMINER  
 30680  
*William E. McGill*  
 WILLIAM E. MCGILL  
 MAY 3, 2011  
 STATE OF OREGON  
 EXPIRES: 12/31/2020

RECEIVED


MAY 13 2019


**WILL MCGILL SURVEYING, LLC**

15333 Pletzer Rd. SE, Turner, OR 97392  
 503-510-3026, willmcgill.surveying@gmail.com

1 2 1 2 1

# Weyerhaeuser Co.; Aurora Forest Nursery - Transfer Application - 72472 IS

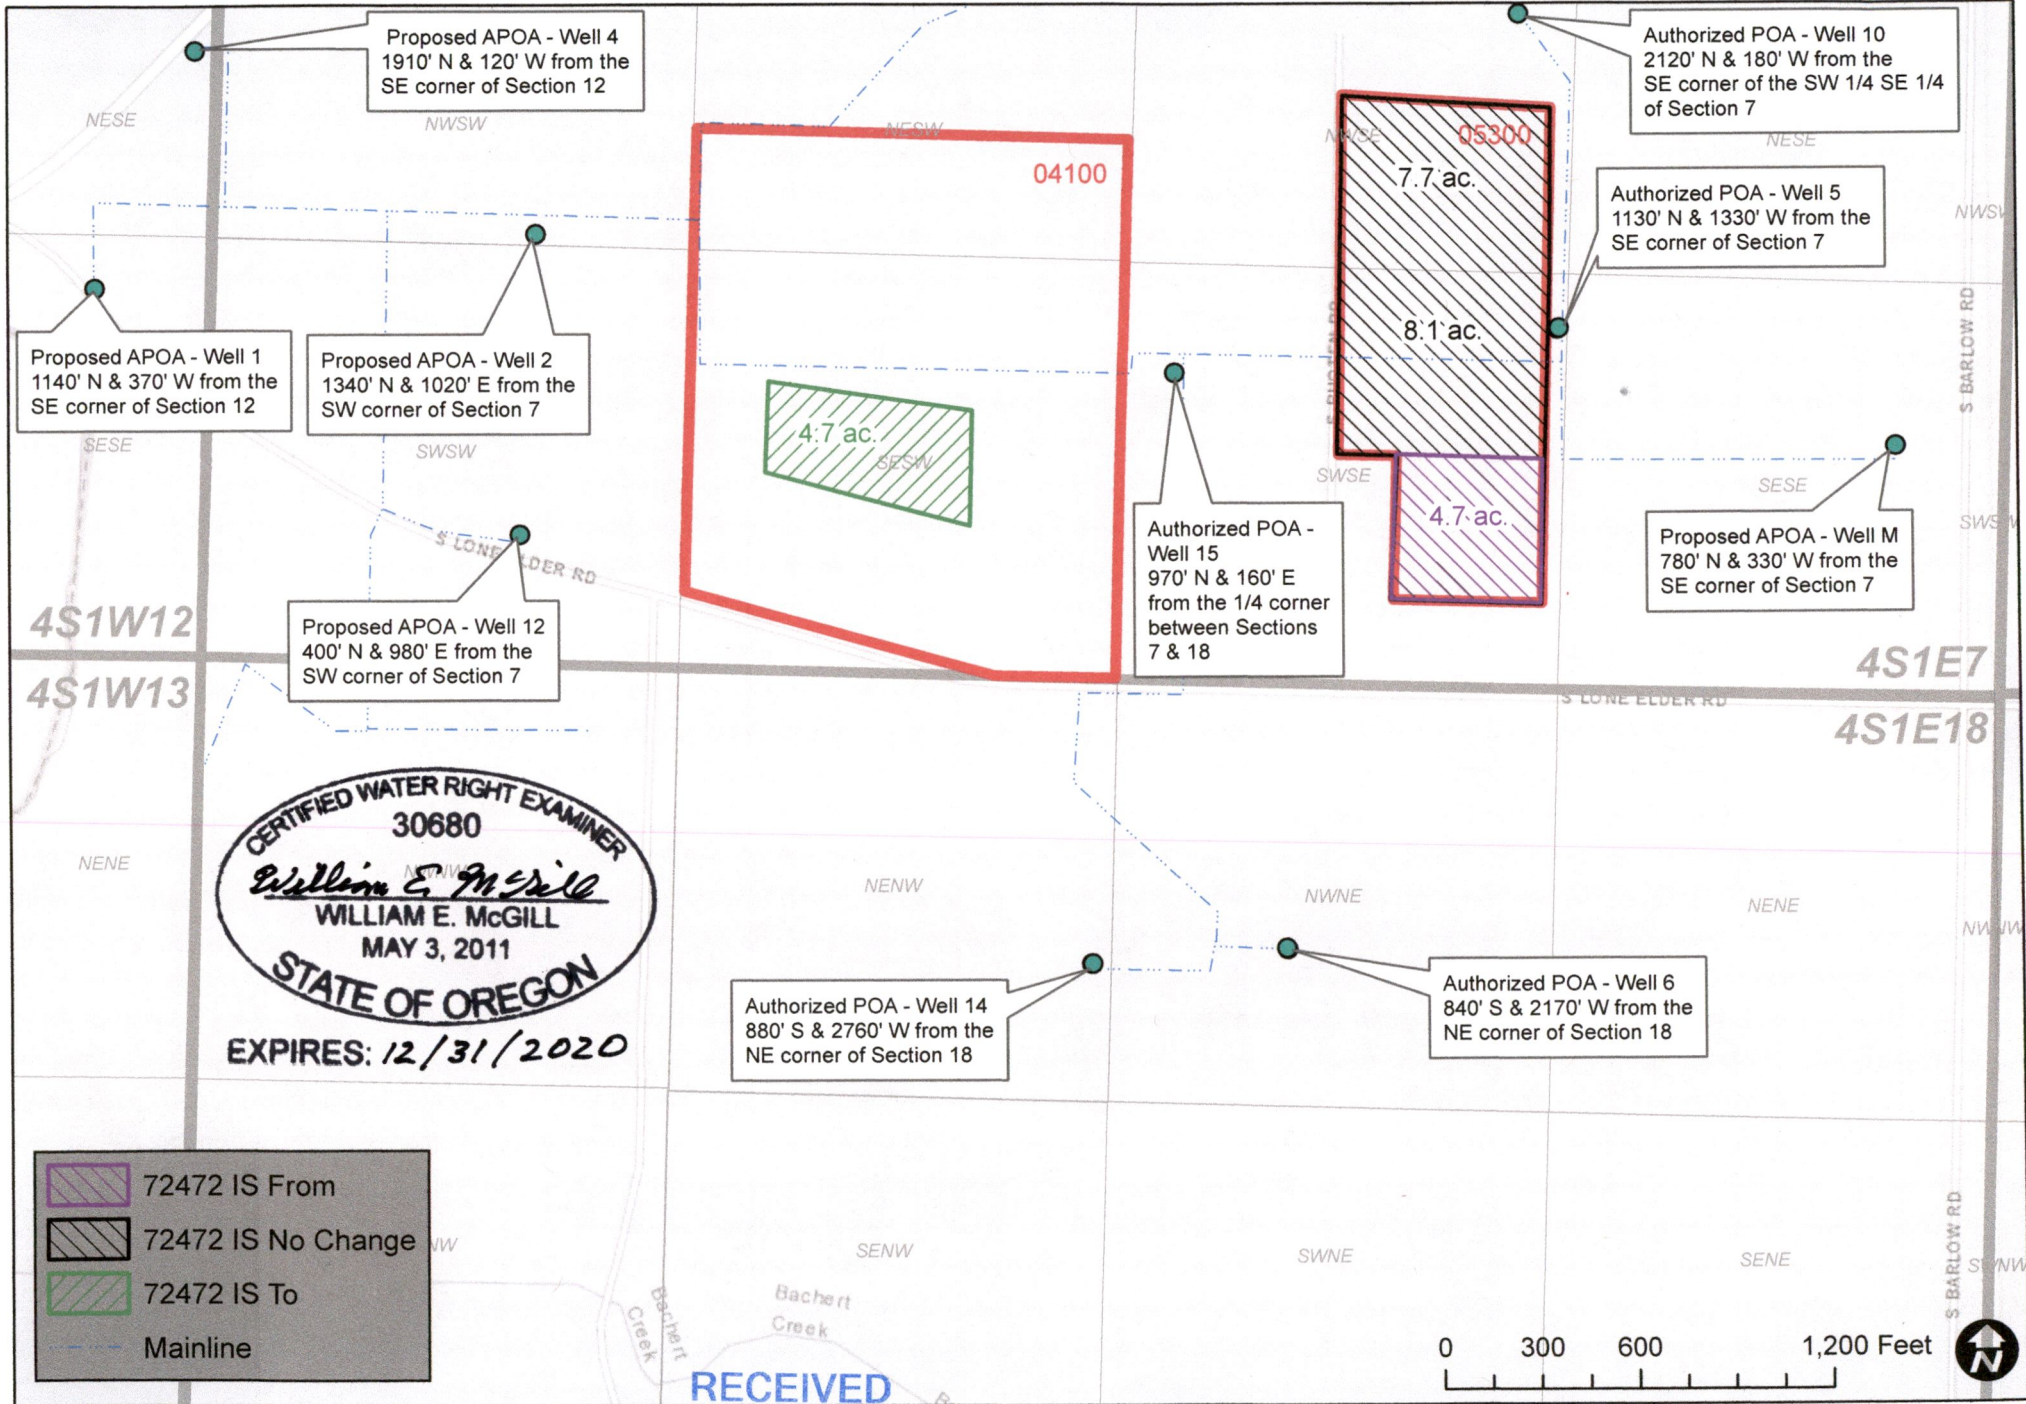

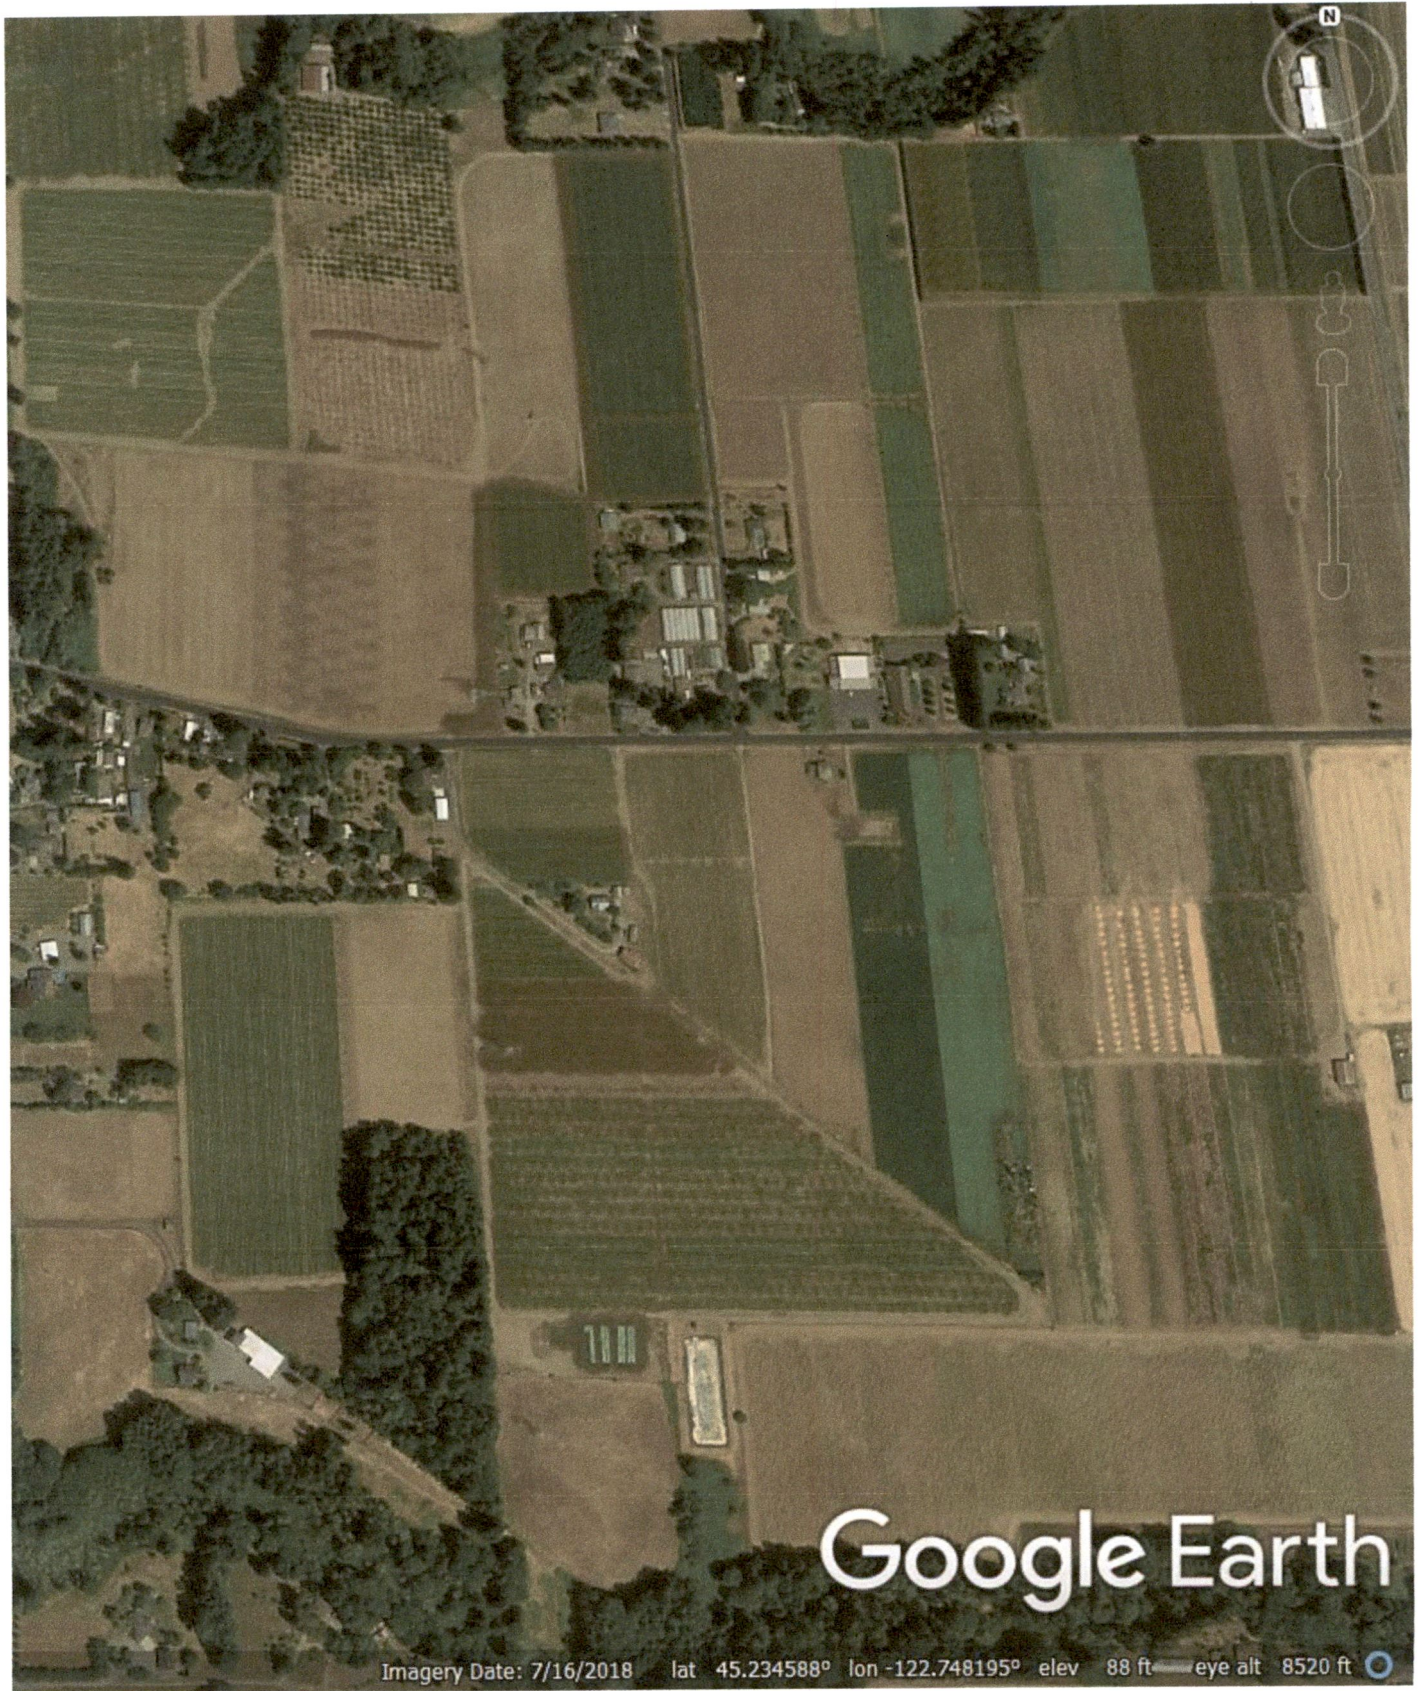

Imagery Date: 7/16/2018 lat 45.234588° lon -122.748195° elev 88 ft eye alt 8520 ft

RECEIVED

MAY 13 2019

OWRD

13181



RECEIVED

MAY 13 2019

OWRD

13181



Imagery Date: 7/23/2016 lat 45.234693° lon -122.748187° elev 87 ft eye alt 8520 ft

RECEIVED

MAY 13 2019

OWRD

13181