


# Map to Accompany a Historic Point of Diversion Change for Norma Apple & Blake Dennis

RECEIVED  
JAN 27 2020  
OWRD

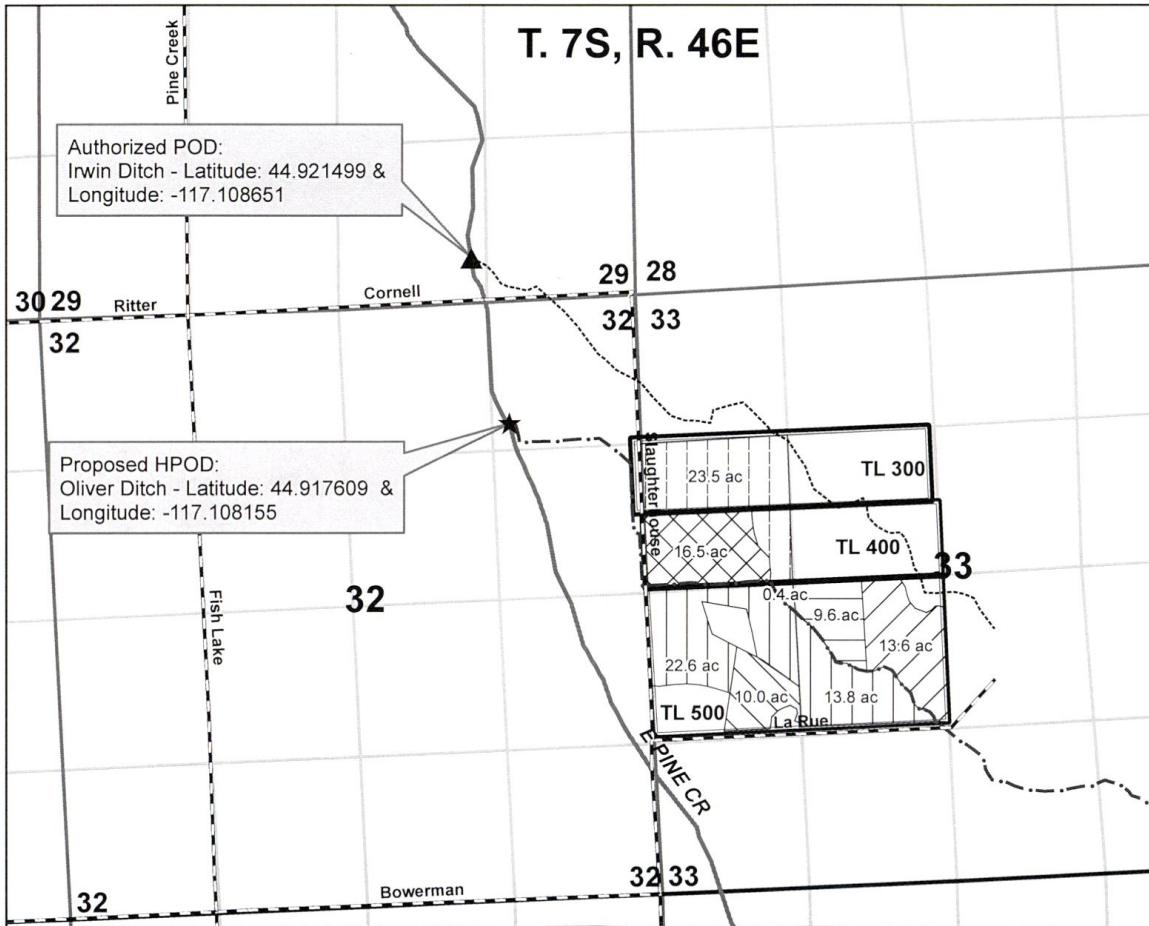

Scale: 1" = 1320' -  
13356'



### Legend

- Irwin Ditch
- .-.- Oliver Ditch

### DennisIR

#### Prior\_, Cert\_

- 1883 - RR, C-63768
- 1883, C-63768
- 1883, T-10289 -RR
- 1914, C-63768

### AppleIR

#### Prior\_, Cert\_

- 1883, C-10249
- 1883-RR, C-10249