


11755

Sec. 27
34

Tp. 115
R. 35 1/2 E


Ap. No. 11755
Per. No. 8200

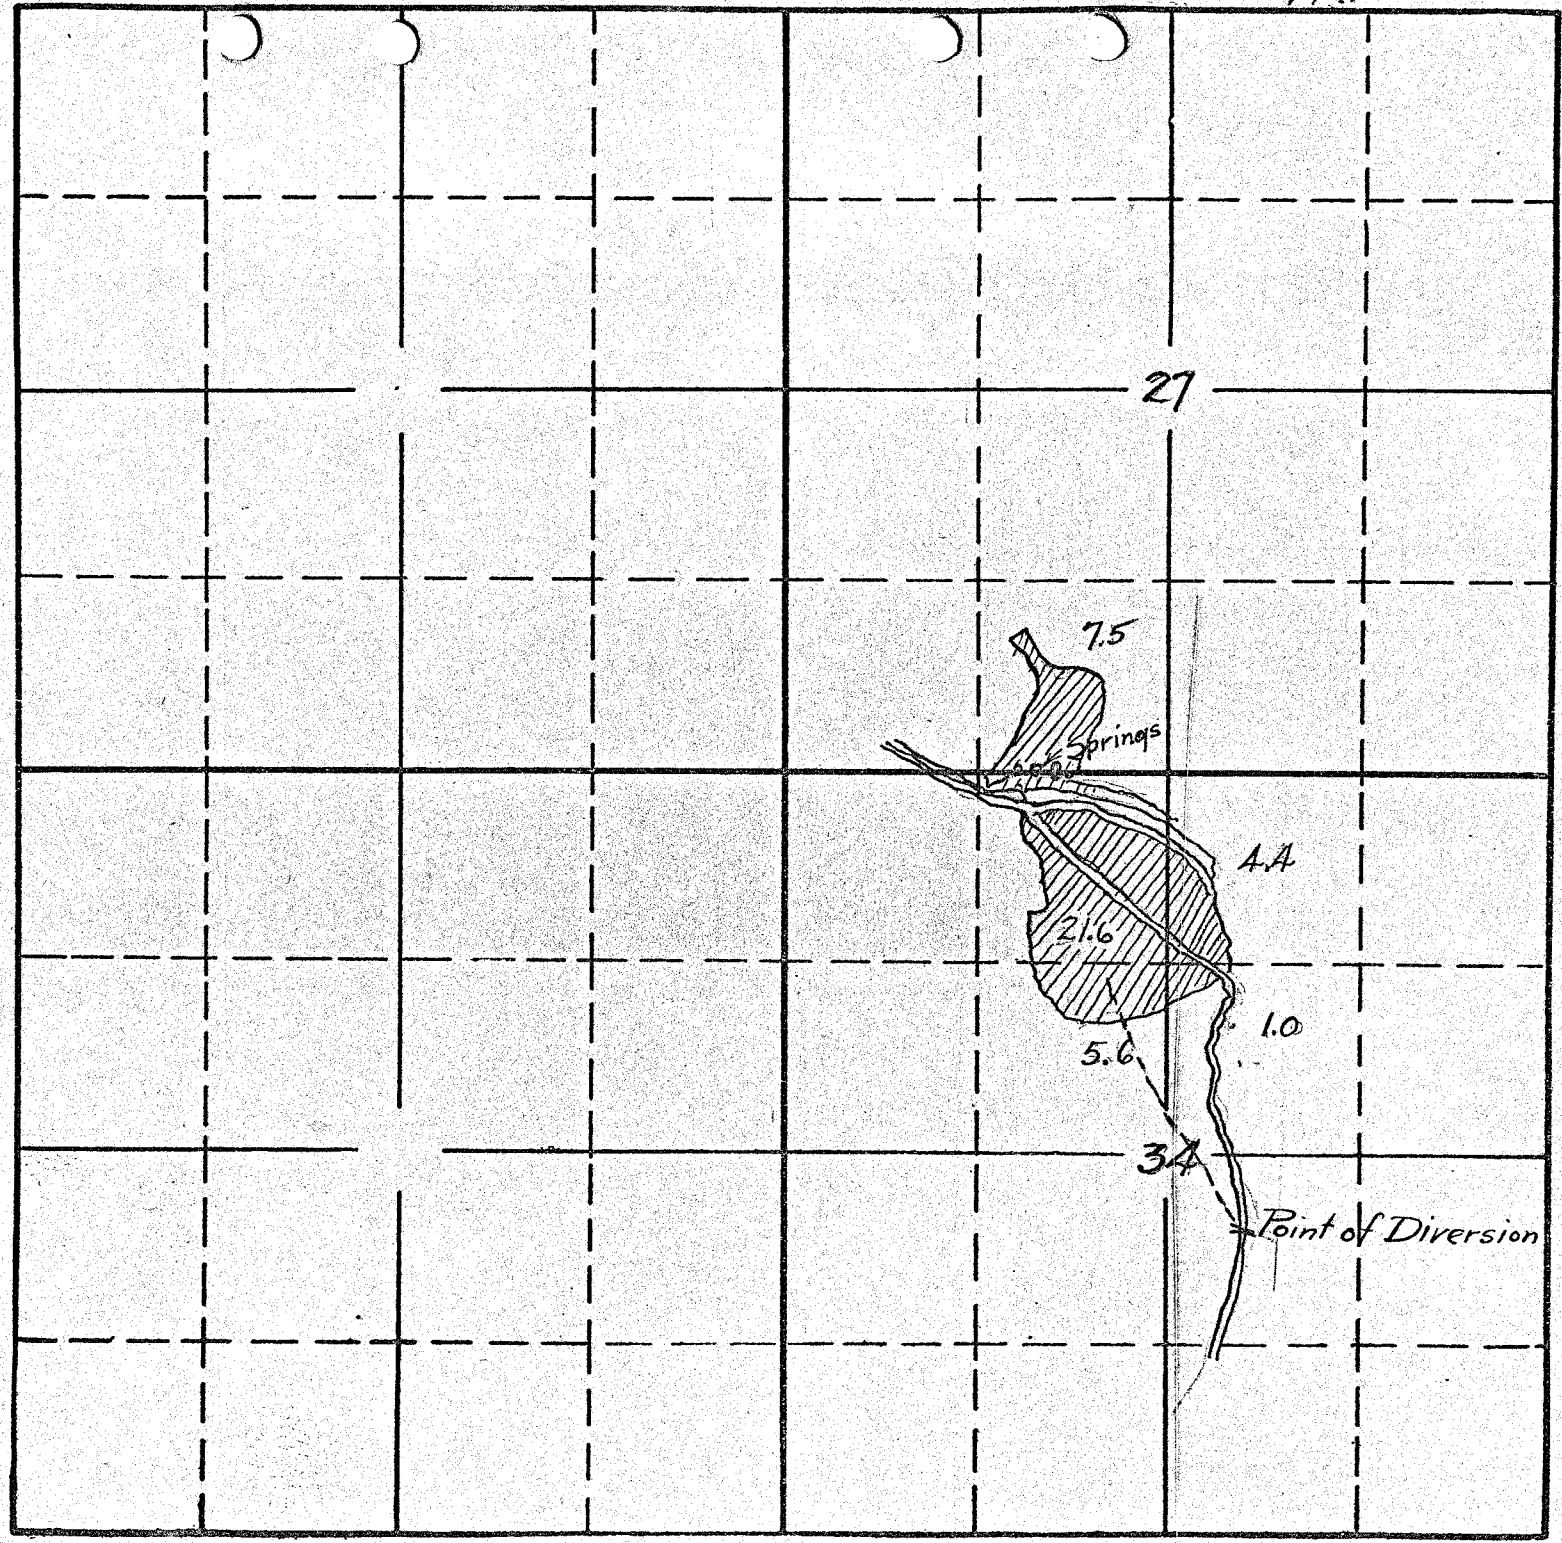

8200
7563

Historic Point of Diversion Application Map
For
David and Sheila Marchbanks
T. 11S R. 35.5 E W.M.


1" = 660 ft.

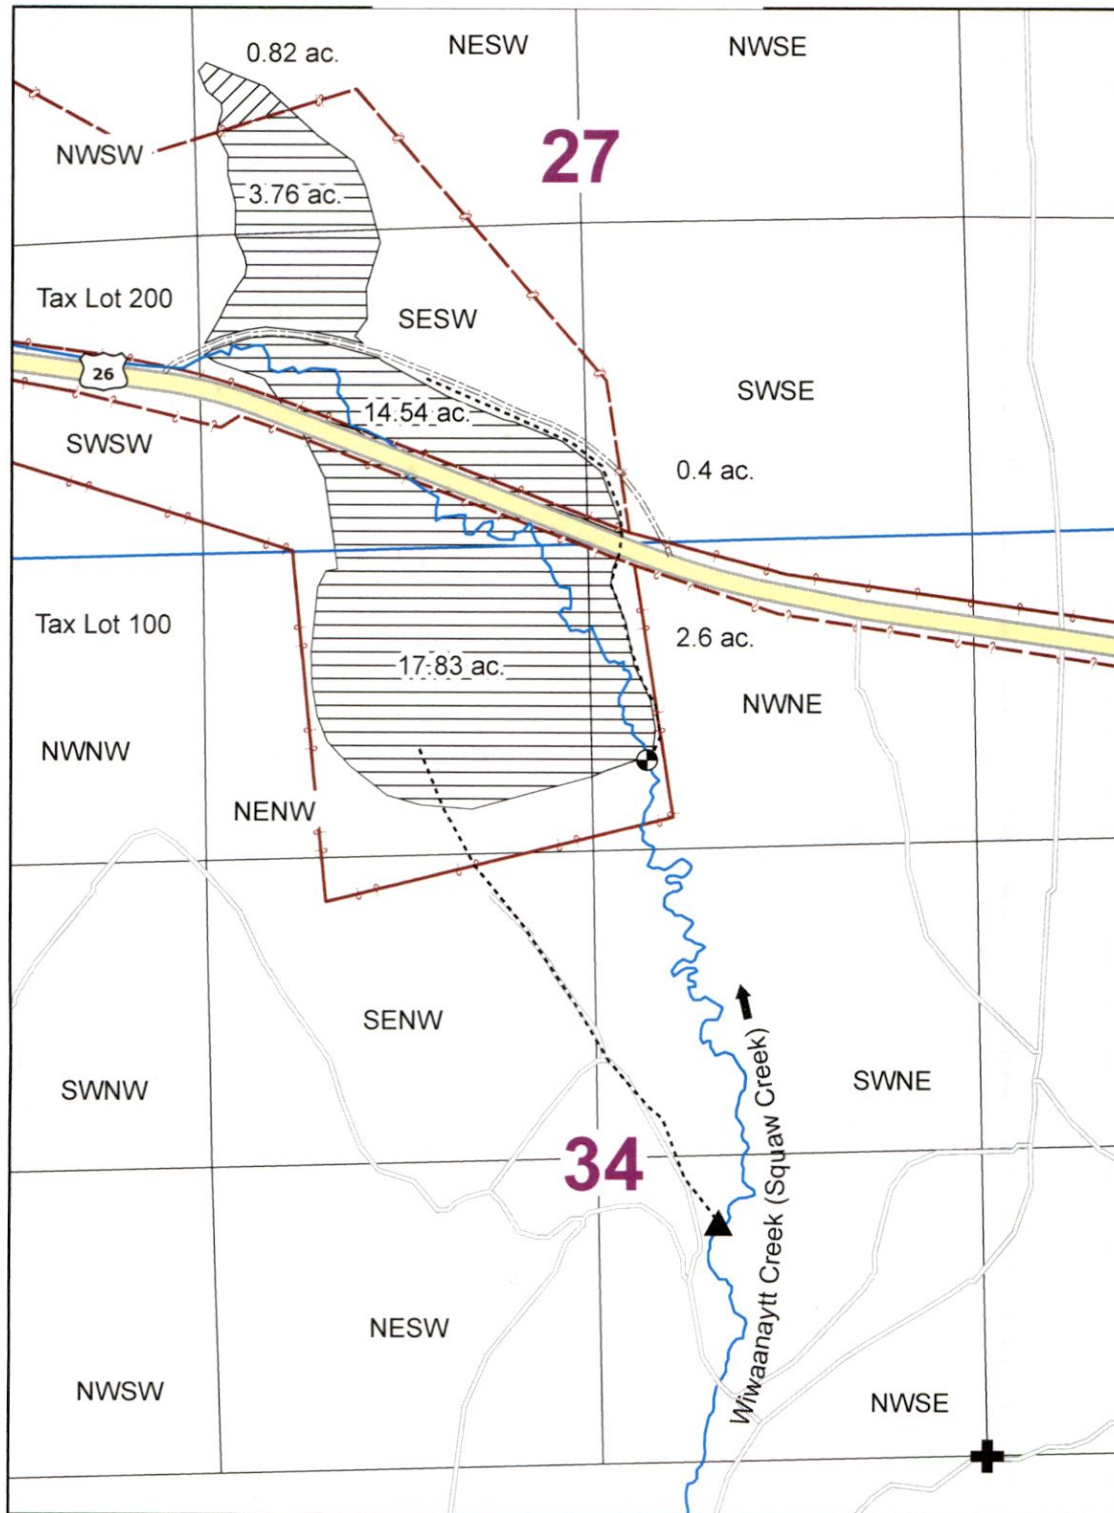

Authorized POD: 811 ft N, 910 ft W from the SE corner of NWSE Sec. 34, T. 11S R. 35.5 E W.M.
Proposed POD: 2412 ft N, 1135 ft W from the SE corner of the NWSE Sec. 34, T. 11S R. 35.5 E W.M.

Legend

- | | | |
|-------|----------------|---|
| ▲ | Authorized POD | Place of Use |
| ● | Proposed POD |  Tax Lot 100 |
| ----- | Ditch |  Tax Lot 200 |

13365 -

RECEIVED

FEB 03 2020

OWRD

C - 84049 Marchbanks 2015 Aerial

Write a description for your map.

RECEIVED
FEB 03 2020

Legend




Google Earth

2000 ft

Historic Point of Diversion Application Map For David and Sheila Marchbanks T. 11S R. 35.5 E W.M.

1" = 660 ft.

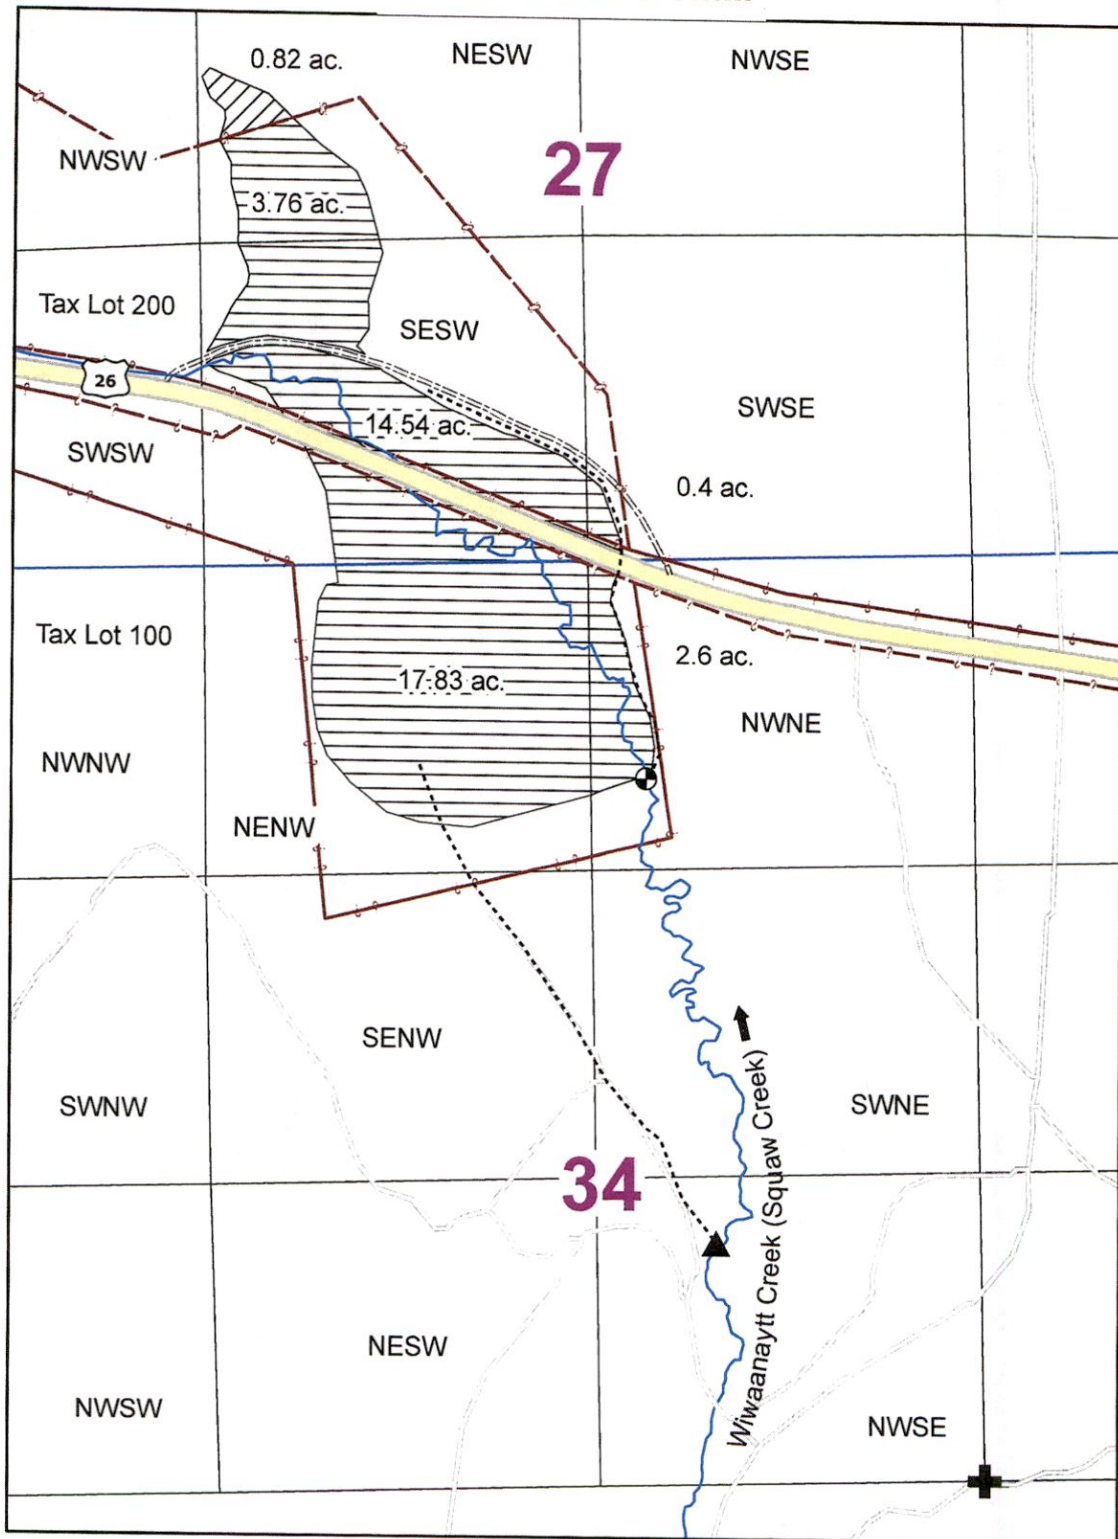

Authorized POD: 811 ft N, 910 ft W from the SE corner of NWSE Sec. 34, T. 11S R. 35.5 E W.M.
Proposed POD: 2412 ft N, 1135 ft W from the SE corner of the NWSE Sec. 34, T. 11S R. 35.5 E W.M.

Legend

- ▲ Authorized POD
- Proposed POD
- Ditch
- Place of Use
- Tax Lot 100
- Tax Lot 200

13365 -

RECEIVED
FEB 03 2020
OWRD