


# FINAL PROOF MAP

## TO CHANGE AND ADD POINTS OF APPROPRIATION AND PLACE OF USE FOR APPLICATION T-12638 ANDY ROOT

TOWNSHIP 26 SOUTH, RANGE 30 EAST, SECTION 9, W.M.  
TAX LOT: 1200



SCALE: 4 INCHES = 1 MILE

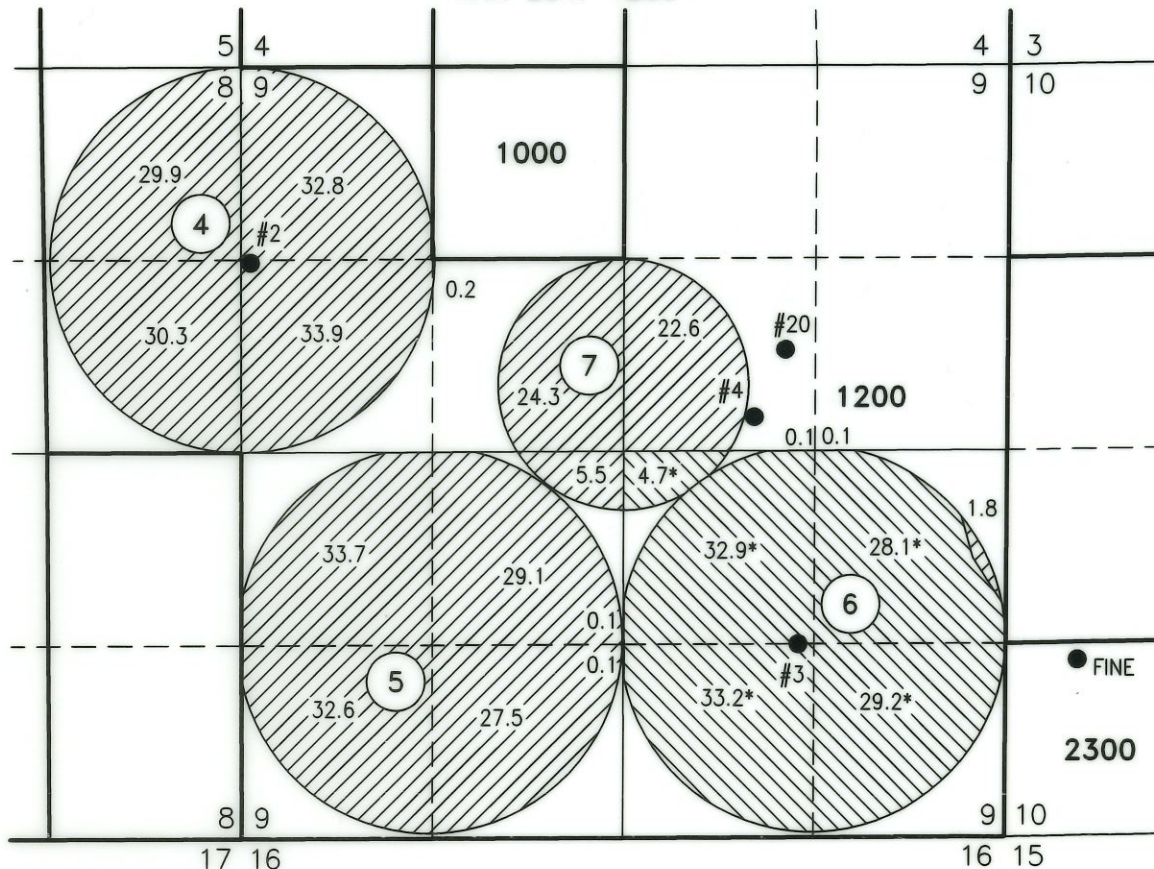

128.1 ACRES PRIMARY RIGHTS (G-5287) AND 128.1 ACRES SUPPLEMENTAL RIGHTS (G-9419) FROM WELLS 2, 4, AND 20 PER T-12638, DEVELOPED AS SHOWN.



RENEWAL DATE: 12/31/2018

THIS MAP IS FOR THE PURPOSE OF LOCATING A WATER RIGHT ONLY AND HAS NO INTENT TO PROVIDE LEGAL DIMENSIONS OR THE LOCATION OF PROPERTY LINES.

WELL 2 (MALH 2324)

- LOCATED IN THE SW 1/4 NW 1/4 SECTION 9, T26S R30E, W.M. AND 1330 FEET SOUTH AND 65 FEET EAST FROM THE NW CORNER OF SAID SECTION. FLOW METER IS LOCATED 7.0' SOUTH FROM WELL.

WELL 4 (HARN 1331)

- LOCATED IN THE SW 1/4 NE 1/4 SECTION 9, T26S R30E, W.M. AND 2407 FEET SOUTH AND 1732 FEET WEST FROM THE NE CORNER OF SAID SECTION. FLOW METER IS LOCATED 6.0' WEST FROM WELL.

WELL 20 (HARN 52457)

- LOCATED IN THE SW 1/4 NE 1/4 SECTION 9, T26S R30E, W.M. AND 1975 FEET SOUTH AND 1525 FEET WEST FROM THE NE CORNER OF SAID SECTION. FLOW METER IS LOCATED 8.0' WEST FROM WELL.

PREPARED FOR:

ANDY ROOT  
524 HIGHWAY 20N  
HINES, OR 97738

PREPARED BY:



ALL POINTS ENGINEERING AND SURVEYING, INC.  
P.O. BOX 767  
(541) 548-5833  
TERREBONNE, OR 97760  
www.APEandS.com