

**T23S R32E, WM
HARNEY COUNTY, OR**



0 1,320
Feet

1" = 1,320'

● Well

⊙ Meter

----- Pipeline


POU IR

Township


Section

----- Quarter Quarter

Taxlot

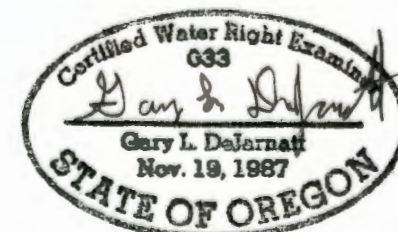

RENEWAL DATE 12/31/2019

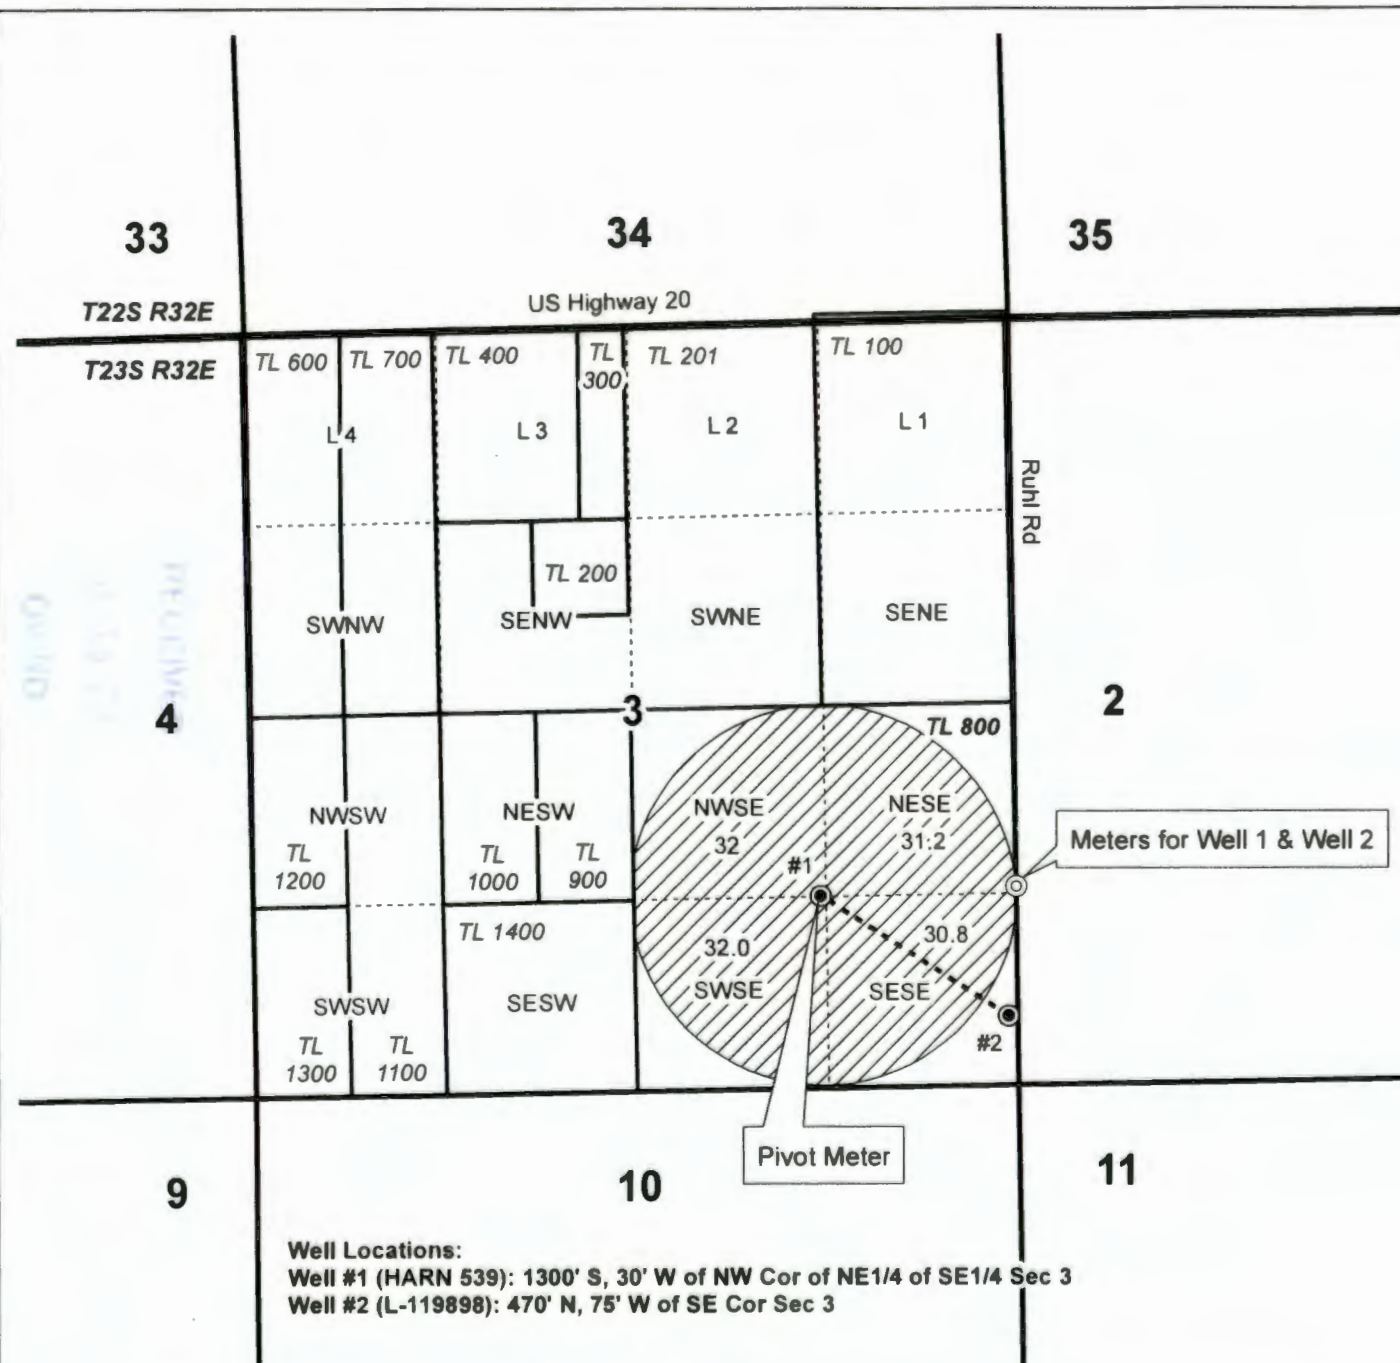

Well Locations:
Well #1 (HARN 539): 1300' S, 30' W of NW Cor of NE1/4 of SE1/4 Sec 3
Well #2 (L-119898): 470' N, 75' W of SE Cor Sec 3

**CLAIM OF BENEFICIAL USE MAP
Roger & Mindy Sheley**

Date: 7/12/2019

Ap G-11220

T-11867

Project #19020

This map is not intended
to provide legal dimensions
or locations of property
ownership lines.

WATER RIGHT SERVICES, LLC
PO BOX 1830, BEND, OR 97709
WWW.OREGONWATER.US CCB # 197121
johnshort@usa.com 541-389-2837