T6S R1E, WM

CLACKAMAS COUNTY

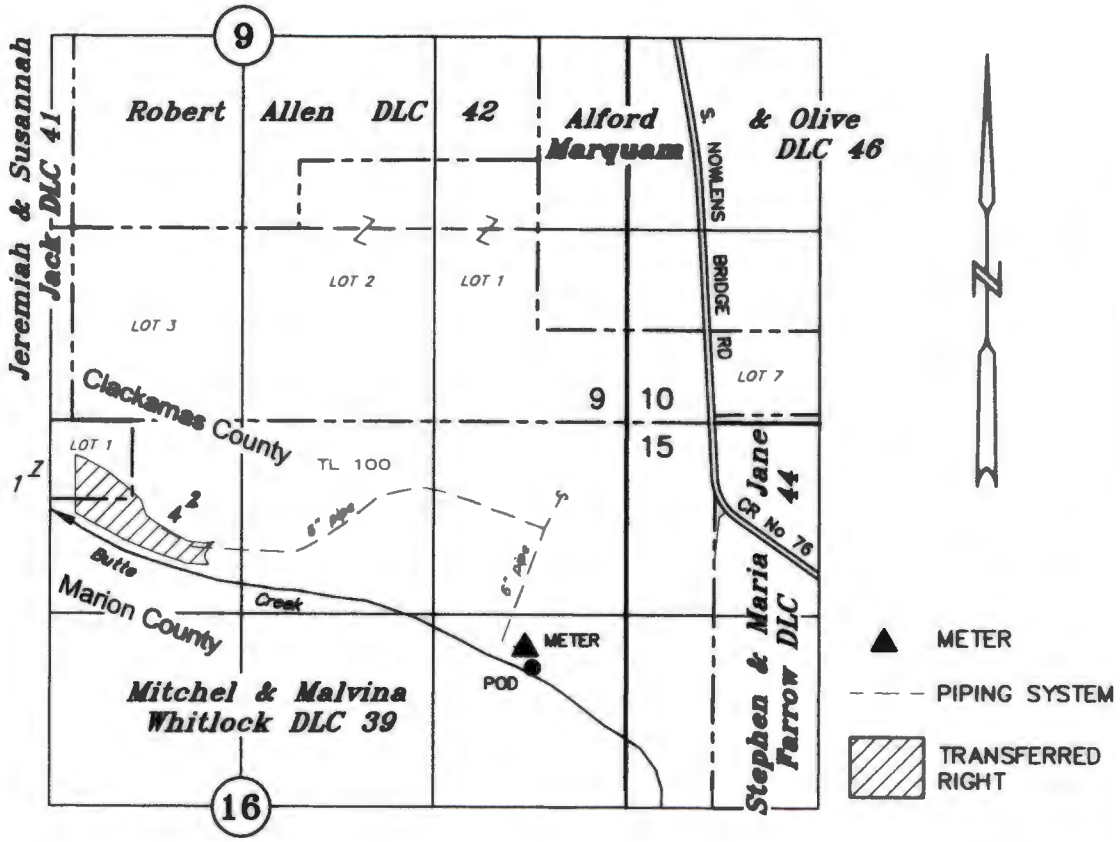

TAX LOT:

6 1E 16
100

POD: 1620' South & 1240' West of NE Cor Mitchel & Malvina Whitlock DLC 39
METER: 1483' South & 1320' West of NE Cor Mitchel & Malvina Whitlock DLC 39

Claim of Beneficial Use

Transfer No. T-11635

RECEIVED
SEP 1 8
OWRD

Missouri Ridge Farms, LLC

September 5, 2014

SCALE: 1" = 1320'

Certified Water Right Examiner
#208 WRE
Corbey Boatwright
Corbey Boatwright
May 30, 1989
STATE OF OREGON

NOTE: This map is for the purpose of identifying the location of water rights and has no intent to dimension or locate property ownership lines.

Renewal Date: December 31, 2019