

FINAL PROOF MAP


TO CHANGE PLACE OF USE AND POINT OF APPROPRIATION
FOR APPLICATION T-12177

NE 1/4 OF SECTION 24,
TOWNSHIP 27 SOUTH, RANGE 17 EAST, W.M.
TAX LOT: 2502

RECEIVED

SEP 03 2019

OWRD

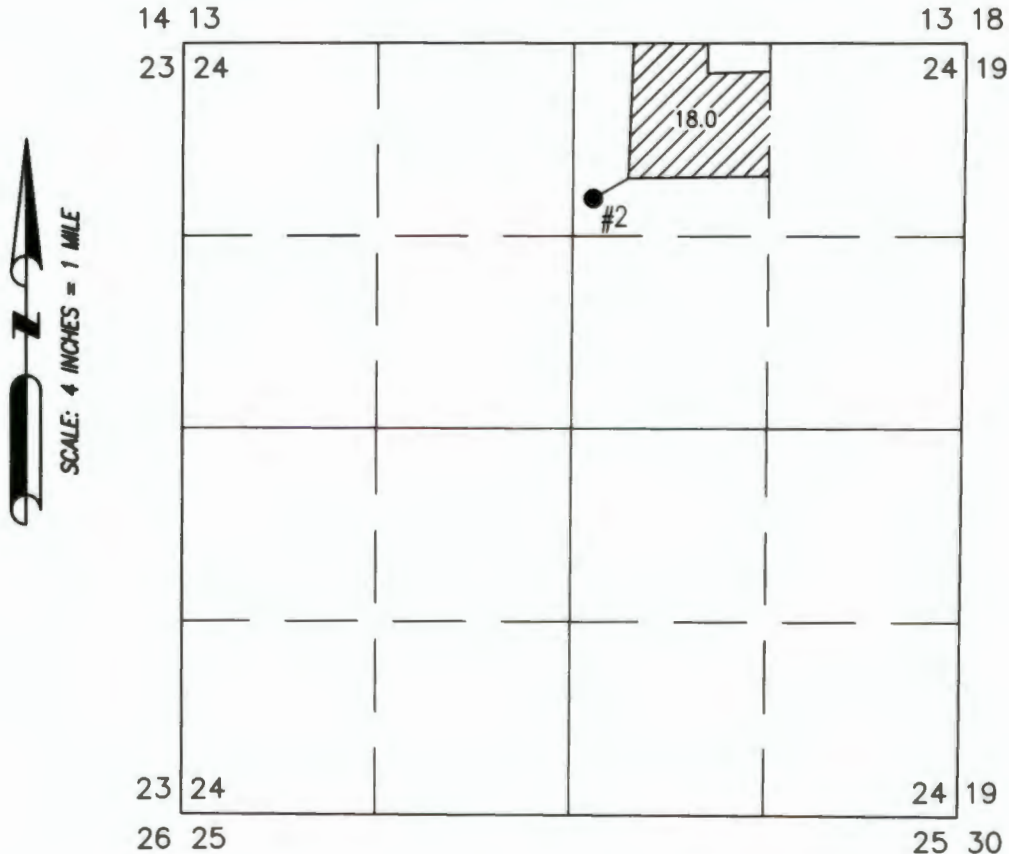


SCALE: 4 INCHES = 1 MILE

18.0 AC IR FROM #2

● #2 (LAKE 1054)

LOCATED IN THE NW 1/4 NE 1/4 SECTION 24, T27S
R17E, W.M. AND 1300 FEET SOUTH AND 2500 FEET
WEST FROM THE NE CORNER OF SECTION 24. FLOW
METER LOCATED 1' E FROM WELL.

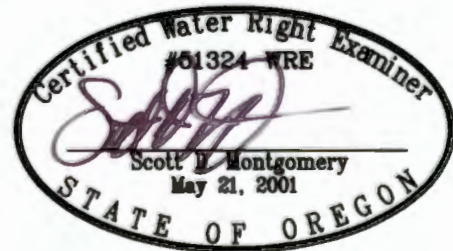

THIS MAP IS FOR THE PURPOSE OF LOCATING A WATER RIGHT
ONLY AND HAS NO INTENT TO PROVIDE LEGAL DIMENSIONS OR
THE LOCATION OF PROPERTY LINES

RENEWAL DATE: 12/31/2020

PREPARED FOR:

TOM & SUZANNE MOREHOUSE
P.O. BOX 13
CHRISTMAS VALLEY, OR 97641

PREPARED BY:



ALL POINTS ENGINEERING AND SURVEYING, INC.
P.O. BOX 767 TERREBONNE, OR 97760
(541) 548-5833 www.APEandS.com