 



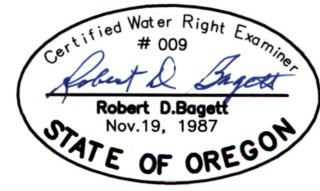
NOV 10 2010

SCALE: 1" = 1320'

-  PLACE OF USE C-48441
-  PLACE OF USE C-24925
- - - - MAINLINE
- () TAX LOT NO.
- (*) ACRES TO BE CANCELED C-48441

Authorized POD is in Government Lot 1, Sec. 30, T.9S., R.28E. (Coordinates Not Available)
 Additional POD 1 is 4810 ft. North & 3820 ft. West of the E1/4 Cor. Sec. 19, T.9S., R.28E.
 Additional POD 2 is 1210 ft. North & 4270 ft. West of the E1/4 Cor. Sec. 19, T.9S., R.28E.
 Additional POD 3 is 760 ft. South & 4410 ft. West of the E1/4 Cor. Sec. 19, T.9S., R.28E.


**APPLICATION MAP
 FOR
 ADDITIONAL POINTS OF DIVERSION
 FOR
 HELEN DAVIDSON, TRUSTEE
 OF THE CLYDE DAVIDSON FAMILY TRUST
 BY
 ROBERT D. BAGETT
 217 N. CANYON BLVD.
 JOHN DAY, OREGON
 (541) 575-1251**



JUNE 25, 2009
 REVISED NOV. 2, 2010

NOTE: THE PREPARATION OF THIS MAP WAS FOR THE PURPOSE OF IDENTIFYING THE LOCATION OF THE PROPOSED WATER RIGHT AND HAS NO INTENT TO PROVIDE DIMENSIONS OR LOCATION OF PROPERTY OWNERSHIP LINES.

T9S, R28E, W.M.

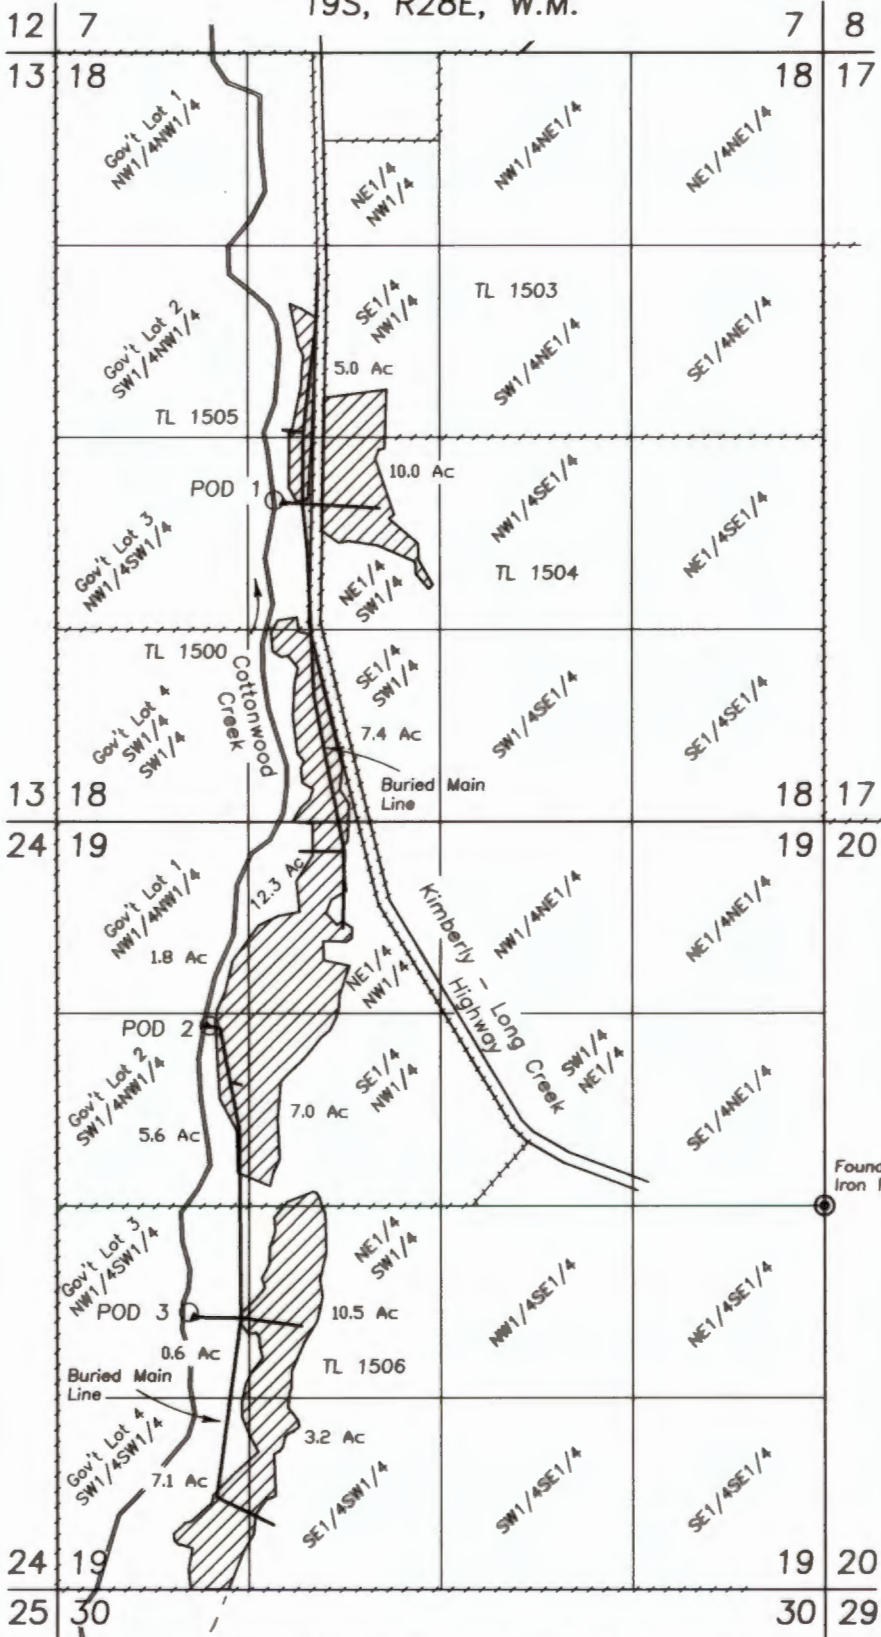

Coordinate ties refer to the E1/4 corner of Section 19, T9S, R28E, W.M.
 Authorized POD 3400 ft S & 5100 ft W
 POD 1 4810 ft N & 3820 ft W; Flow meter is SE 36'
 POD 2 1210 ft N & 4270 ft W; Flow meter is E. 11'
 POD 3 760 ft S & 4410 ft W; Flow meter is SE 22'
 A fish Screen is 15 ft. west of each POD lying in the creek.

NOTE: The preparation of this map was for the purpose of identifying the location of the proposed water right and has no intent to provide dimensions or location of property ownership lines.

CLAIM OF BENEFICIAL USE
 For
 Triple 7 Ranch, LLC
 Application #T-10934

RECEIVED
 AUG 19 2019
 OWRD



SCALE 1"=1320'
 January 16, 2019

Prepared by
 Cornerstone Surveying, Inc
 Carl Stout
 P.O. BOX 33
 JOHN DAY, OR. 97845
 (541)575-1813
 jwsurvey55@gmail.com

- LEGEND
- ▲ Flow Meter
 - ▨ Place of Use
 - Tax Lot Boundary
 - Tax Map 9S28E
 - Tax Lots 1500, 1503, 1504, 1505, 1506

