


**T.4S. R.4W. Sec. 36; T.5S. R.3W. Sec. 6;  
T.5S. R.4W. Sec. 1, W.M.**

RECEIVED

DEC 05 2017

OWRD

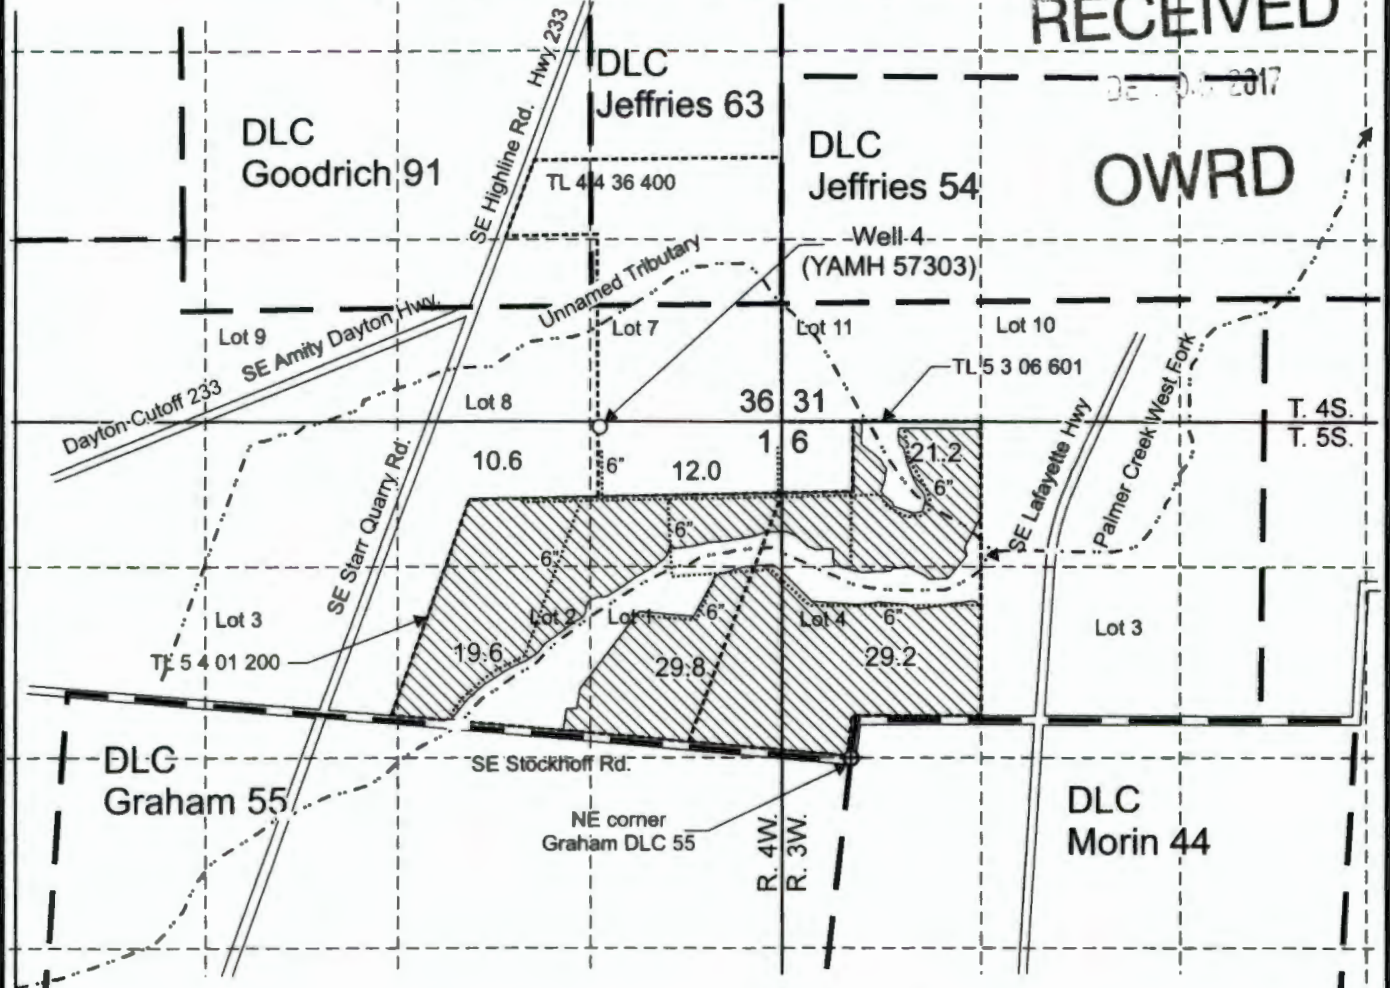


Well 4 (YAMH 57303) is located 35 feet south and 1,265 west from the NE corner, Section 1.

 Area (122.4 acres) authorized under Certificate 50250.

 Tax lot boundary

 Donation Land Claim Boundary

 Mainline connecting Well 2 to existing system



Scale: 1" = 1,320'



This map was prepared for the purpose of identifying the location of a water right only and is not intended to provide legal dimensions or location of property ownership lines.

**Claim of Beneficial Use Map  
T-11885**

Gary Cruickshank

T.4S. R.4W. Section 36; T.5S. R.3W. Section 6;  
T.5S. R.4W. Section 1, W.M.

Pacific Hydro-Geology Inc.

11/2017