


WATER RIGHTS CLAIM OF BENEFICIAL USE MAP  
 FOR  
 USDA FOREST SERVICE,  
 MIDDLE FORK RANGER DISTRICT  
 LOCATED IN THE  
 NW 1/4 OF THE SW 1/4 OF SECTION 23,  
 TOWNSHIP 21 SOUTH, RANGE 3 EAST, W.M.  
 TAX LOTS # 104, 105, 107 AND 108  
 LANE COUNTY, OREGON  
 JANUARY 16, 2018  
 APP # S-87499, PERMIT # S-54754

WEST 1/4 SEC 23

960'  
 SOUTH




LEGEND	
	SUMMER CABIN
	APPROX PROPERTY CORNER
	POD SUCTION W/SCREEN
	QUARTER CORNER
	PUMP HOUSE W/ METER

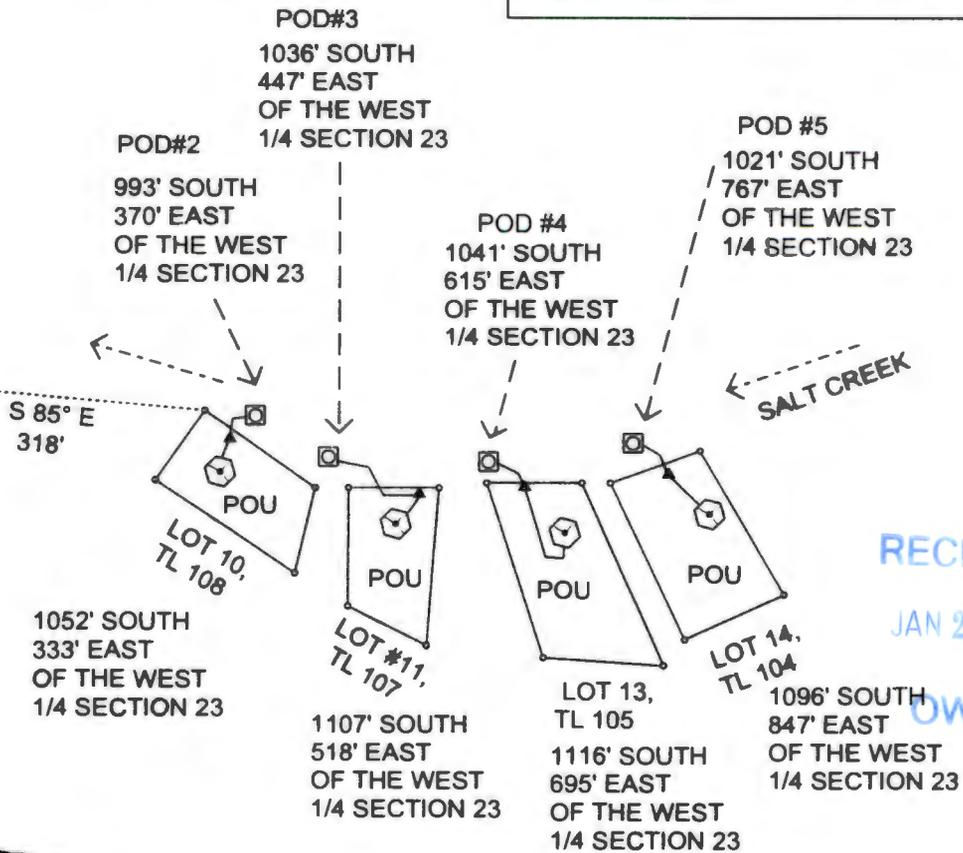

RECEIVED

JAN 29 2018

OWRD

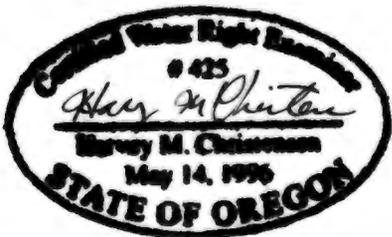

DISCLAIMER: THIS MAP IS NOT TO BE  
 USED FOR PROPERTY LOCATION. IT  
 IS FOR WATER RIGHT PURPOSES ONLY.