


**T24S R32.5E, WM,
HARNEY COUNTY, OR**

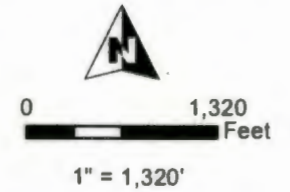

● Well & Meter

----- Pipeline


 POU IR (121.5 AC)

 Township


 Section

----- Quarter Quarter

 Taxlot

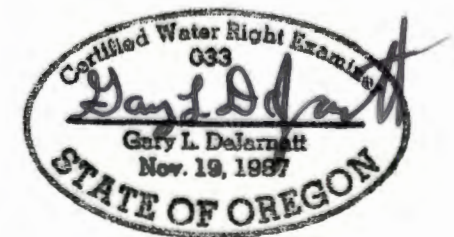

RENEWAL DATE 12/31/2019

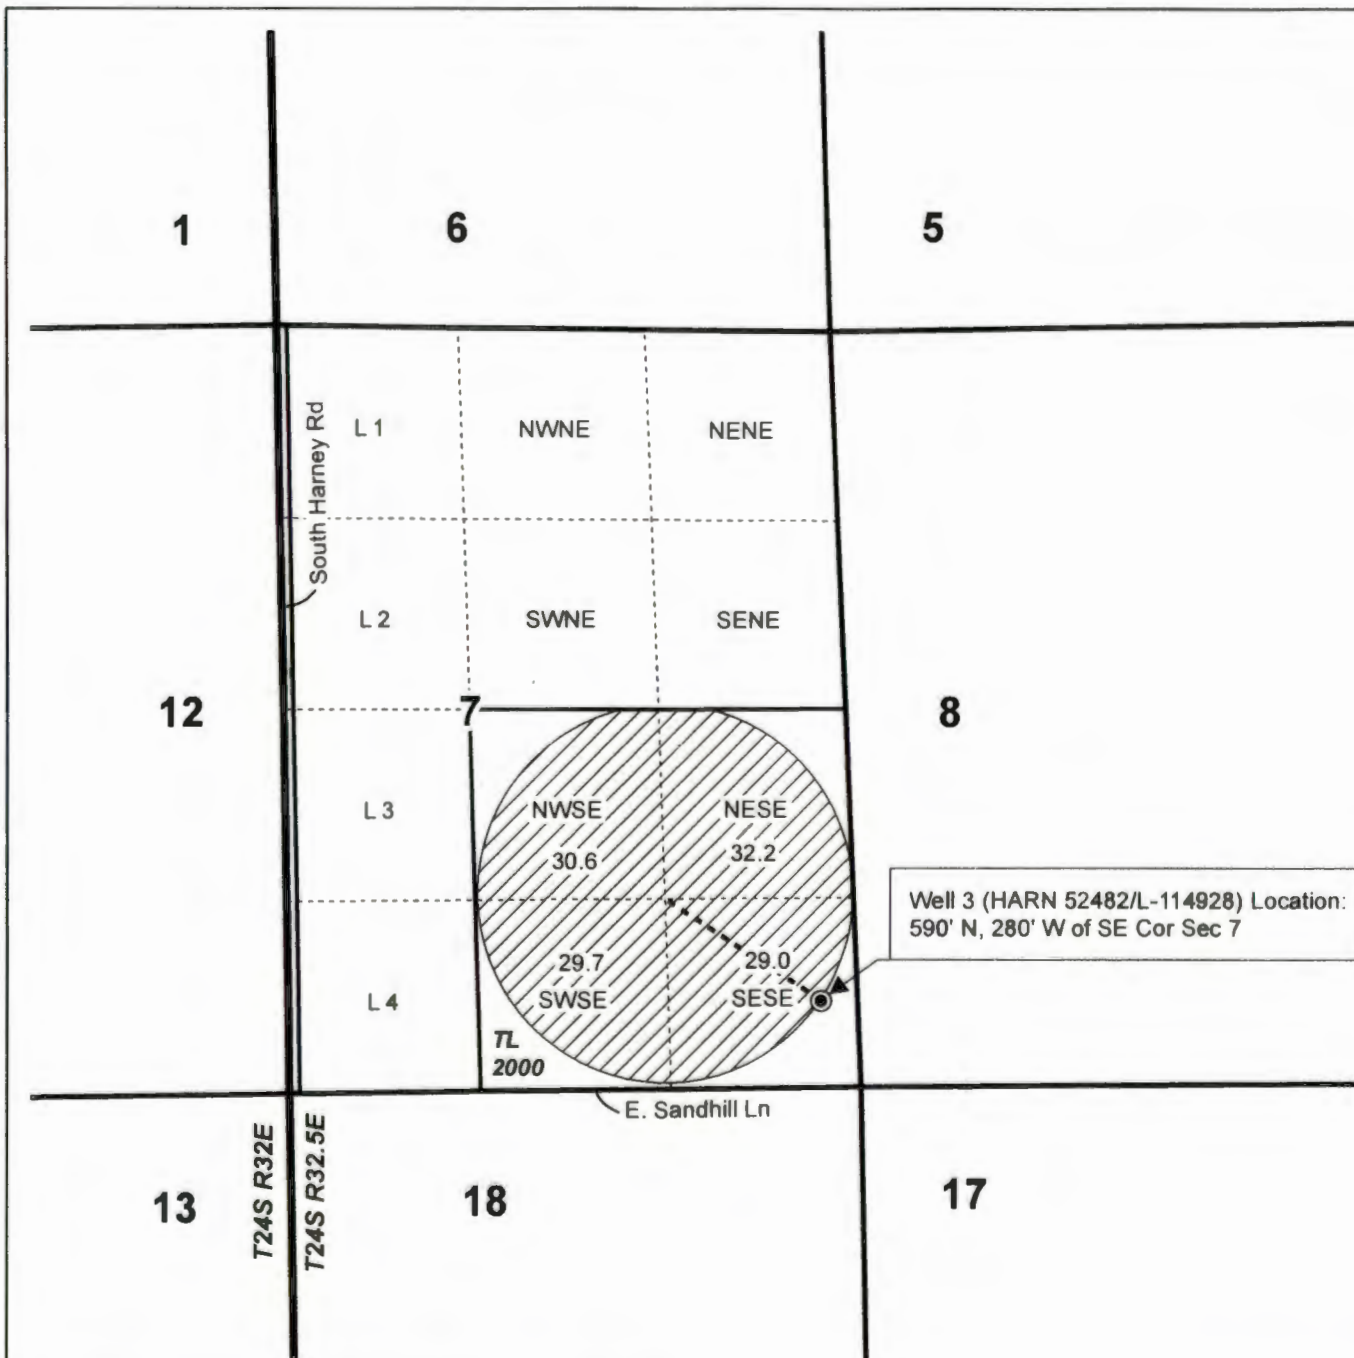

**CLAIM OF BENEFICIAL USE MAP
DEAN AND JODI NIKKEL**

Date: 9/19/2019

Ap G-17235 Permit G-17234

Project #19043

This map is not intended
to provide legal dimensions
or locations of property
ownership lines.

WATER RIGHT SERVICES, LLC
PO BOX 1830, BEND, OR 97709
WWW.OREGONWATER.US CCB # 197121
johnshort@usa.com 541-389-2837