


RECEIVED BY OWRD

JUL 16 2014

SALEM, OR

T24S R31E / T25S R31E

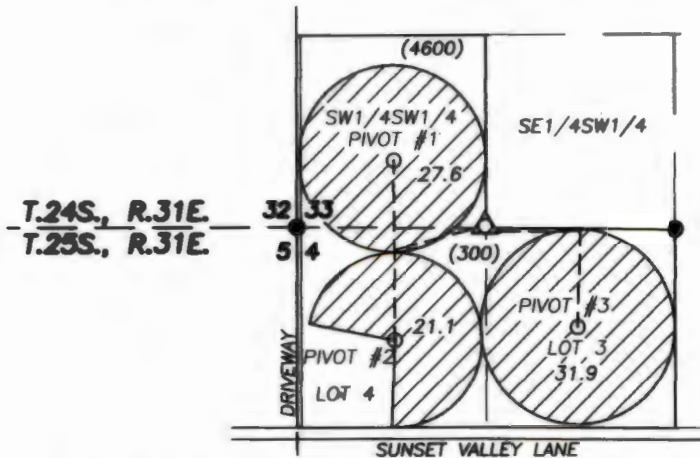

POA IS 0 FT. NORTH AND 1290 FT. EAST FROM THE
NORTHEAST CORNER OF SECTION 4, T.25S., R.31E

NW AC/WED



SCALE: 1" = 1320'

FINAL PROOF SURVEY
APPLICATION NO. G-14844
PERMIT NO. G-13662

IN NAME OF
S. LEE WILSON

BY

ROBERT D. BAGETT
217 N. CANYON BLVD.
JOHN DAY, OREGON
(541) 575-1251

DATE SURVEYED: JUNE 24, 2014

● FOUND RECORD SURVEY
MONUMENT


△ POA - WELL #1

○ CENTER PIVOT AND FLOW METER

--- EXISTING MAINLINE

▨ CURRENT PLACE OF USE

() TAX LOT

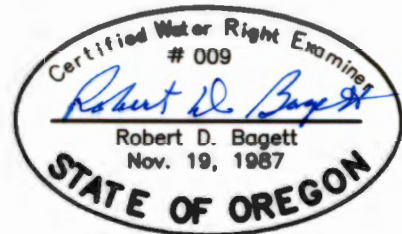

Renews 12/31/2015

NOTE: THE PREPARATION OF THIS MAP WAS
FOR THE PURPOSE OF IDENTIFYING THE
LOCATION OF THE PROPOSED WATER RIGHT
AND HAS NO INTENT TO PROVIDE DIMENSIONS
OR LOCATION OF PROPERTY OWNERSHIP LINES.