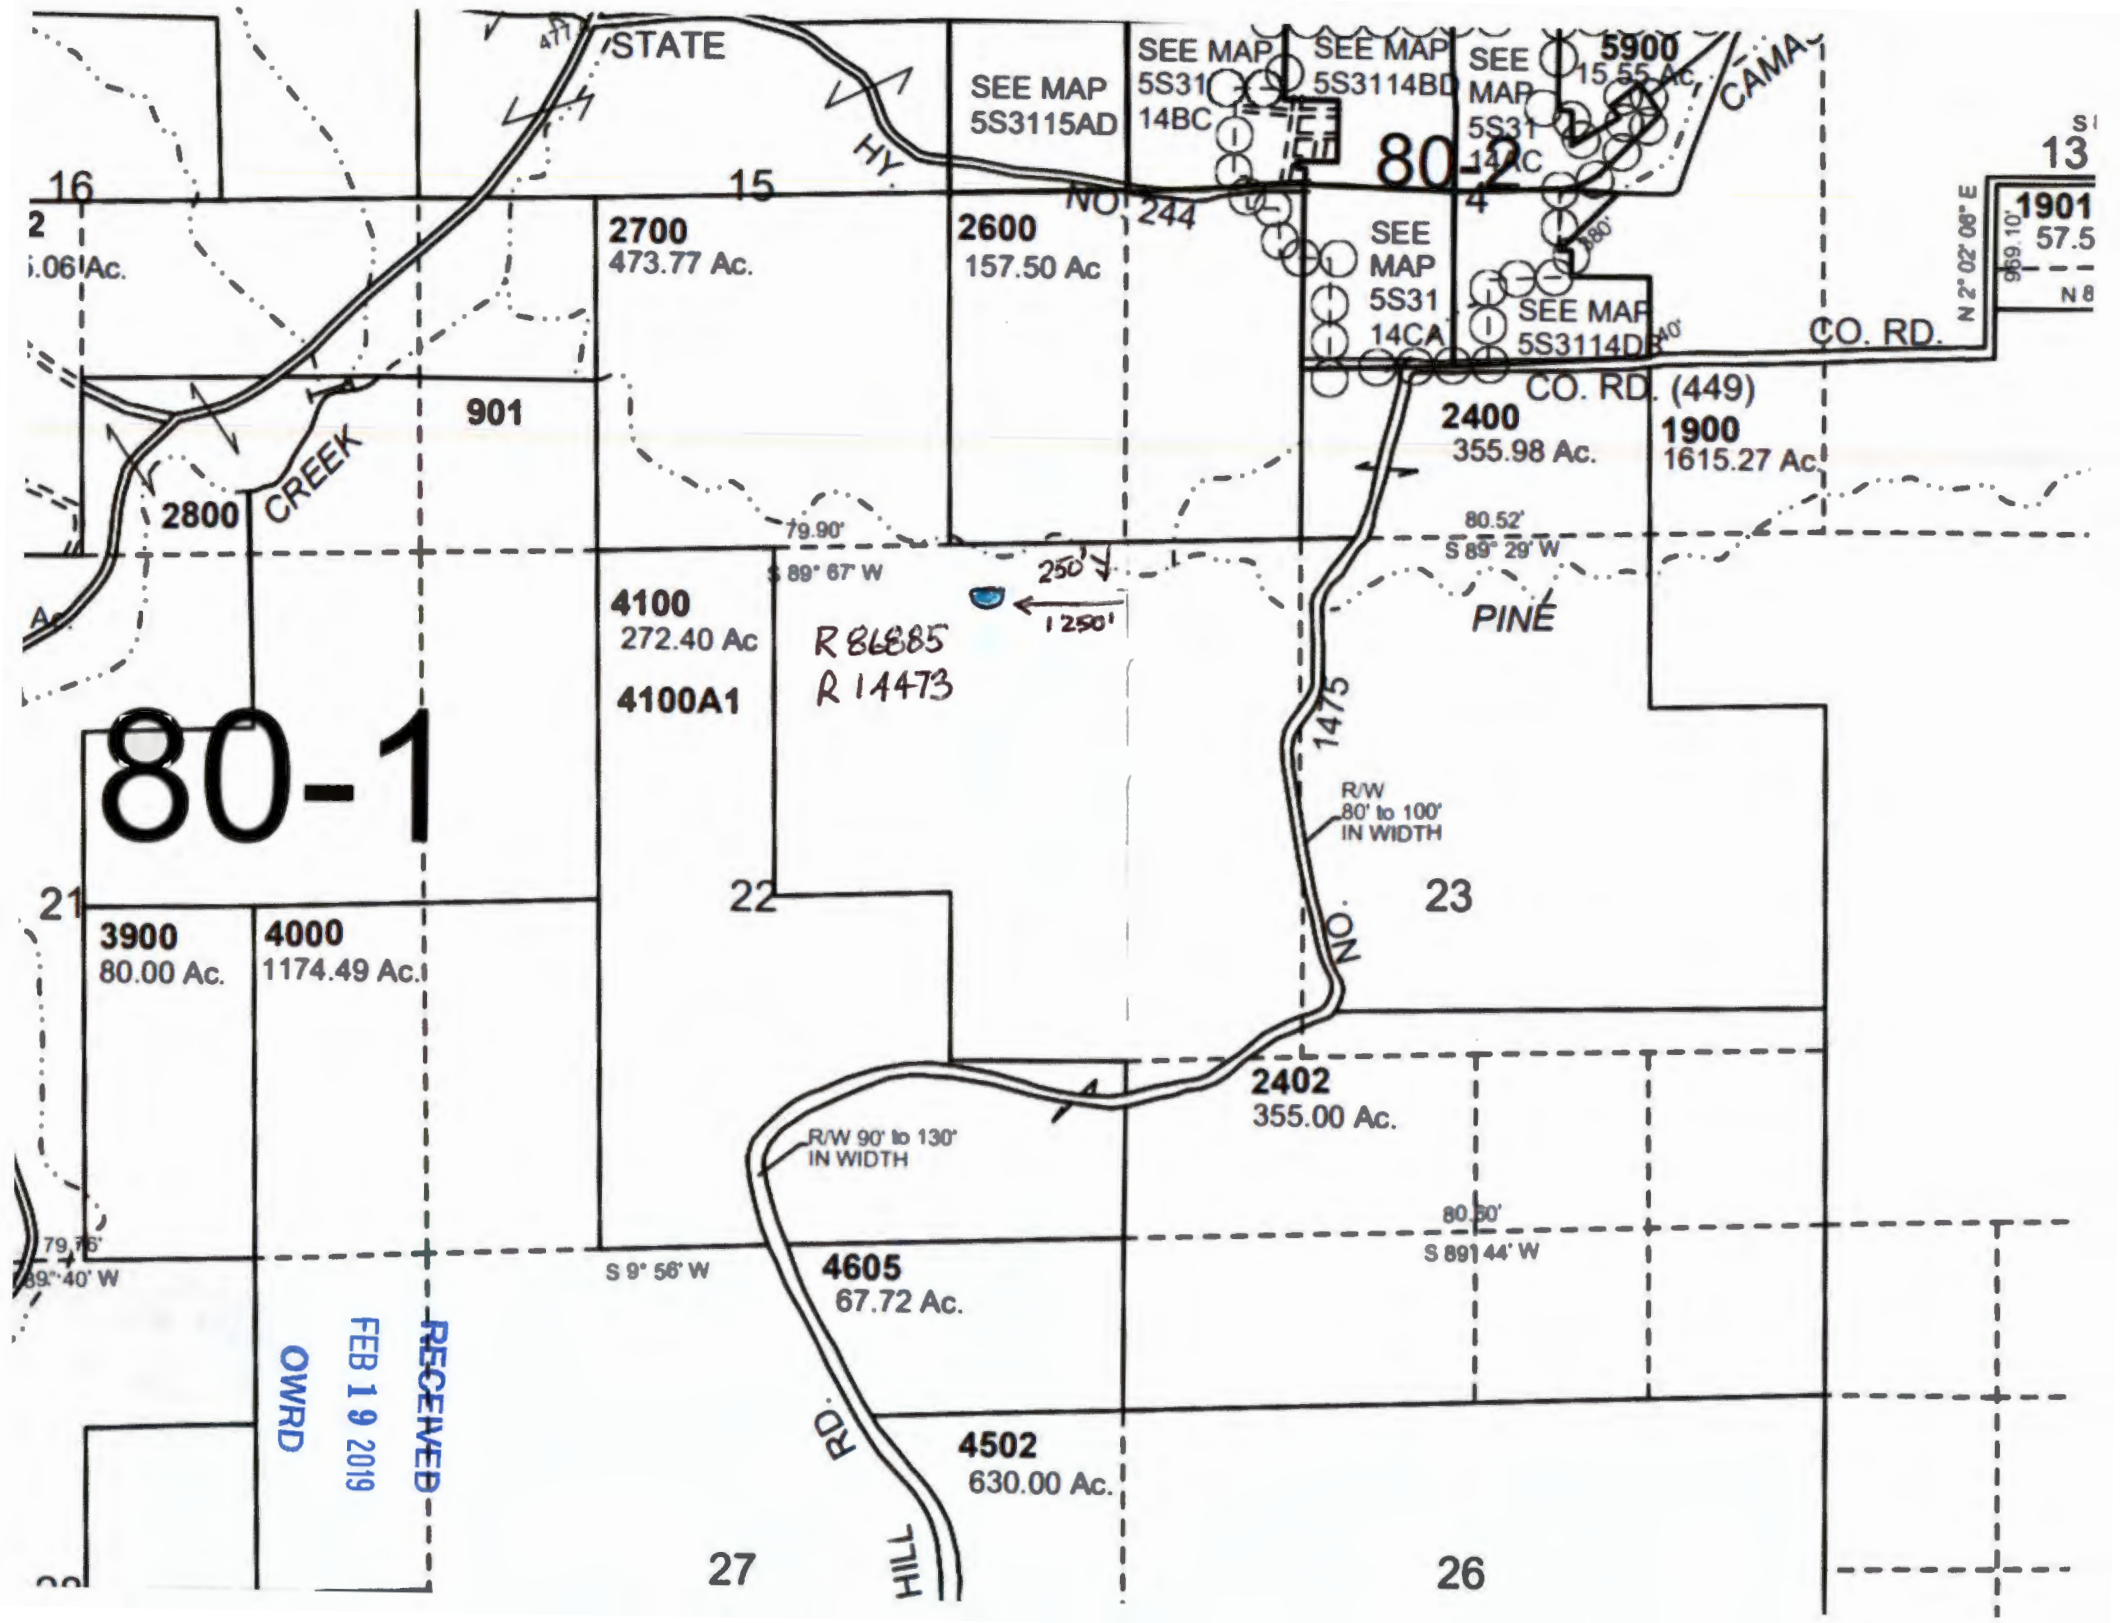
80-1
80-2
STATE
HY.
NO. 244
CAMA
CO. RD.
CO. RD. (449)
CREEK
PINE
NO.
HILL RD.
SEE MAP 5S3115AD
SEE MAP 5S31 14BC
SEE MAP 5S3114BD
SEE MAP 5S31 14AC
SEE MAP 5S31 14CA
SEE MAP 5S3114DB
2700 473.77 Ac.
2600 157.50 Ac
5900 15.55 Ac.
1901 57.5
2400 355.98 Ac.
1900 1615.27 Ac.
2800
901
4100 272.40 Ac
4100A1
R 86885
R 14473
1475
R/W 80' to 100' IN WIDTH
R/W 90' to 130' IN WIDTH
2402 355.00 Ac.
3900 80.00 Ac.
4000 1174.49 Ac.
4605 67.72 Ac.
4502 630.00 Ac.
79.90' S 89° 67' W
80.52' S 89° 29' W
80.30' S 89° 44' W
S 9° 56' W
N 2° 02' 06" E
969.10'
250'
1250'
16
15
13
21
22
23
27
26
RECEIVED
FEB 19 2019
OWRD