


Sec 8 T 2 S R 5 E.

n

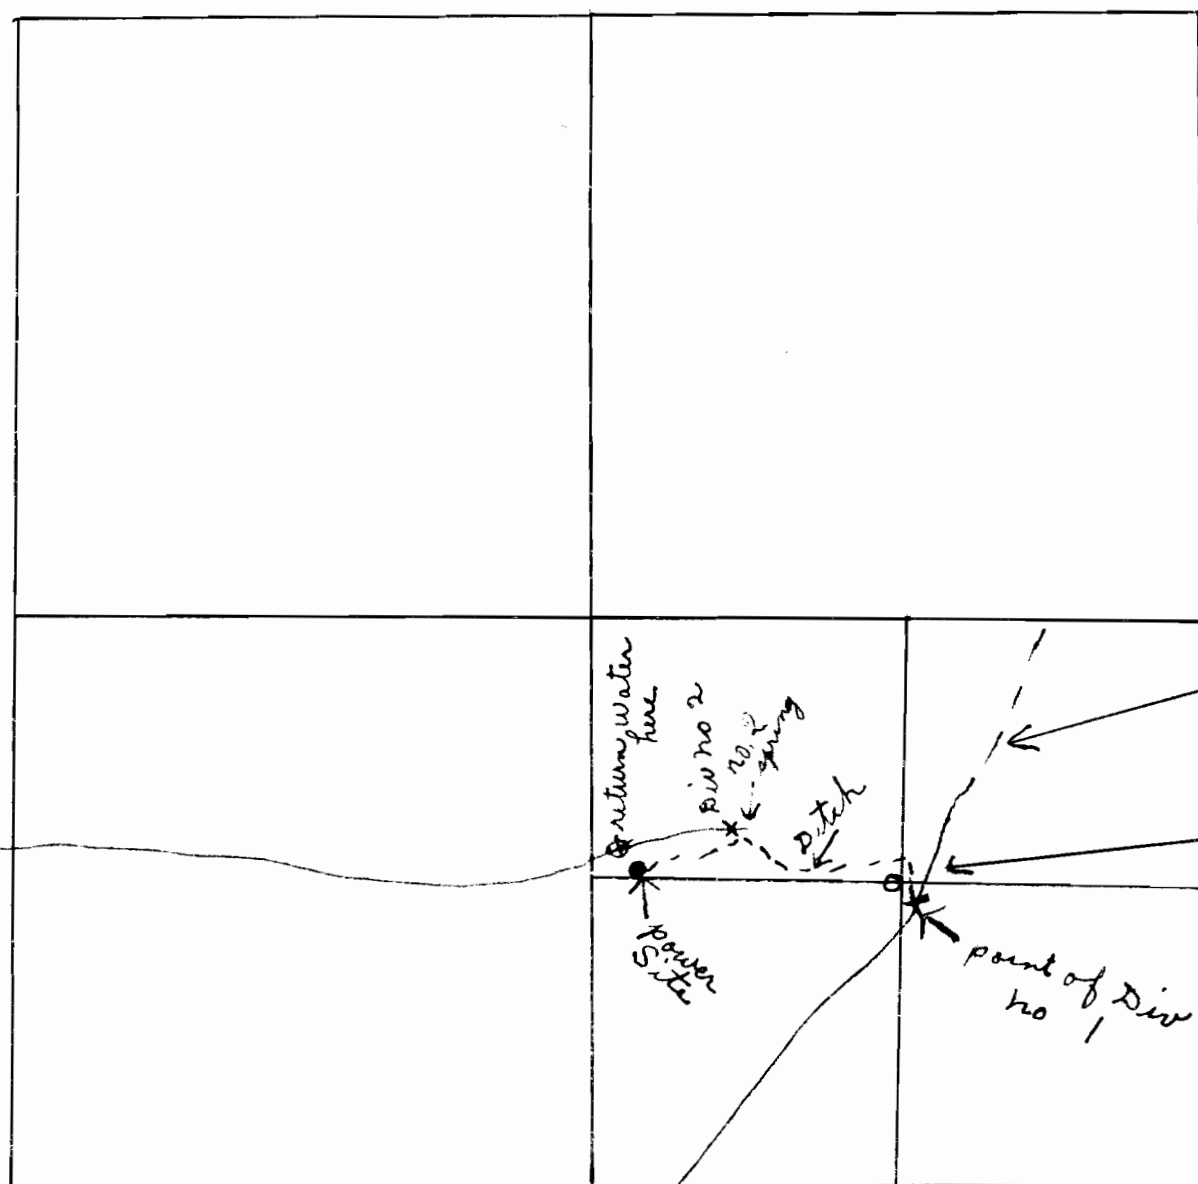

Application No. 12116

Permit No. 8591