


ALTERNATE RESERVOIR APPLICATION

Township 12 S., Range 2 W., W.M. Section 35, Tax Lot 1600

David Stibgen - 30731 Carnelian Court, Lebanon, OR 97355

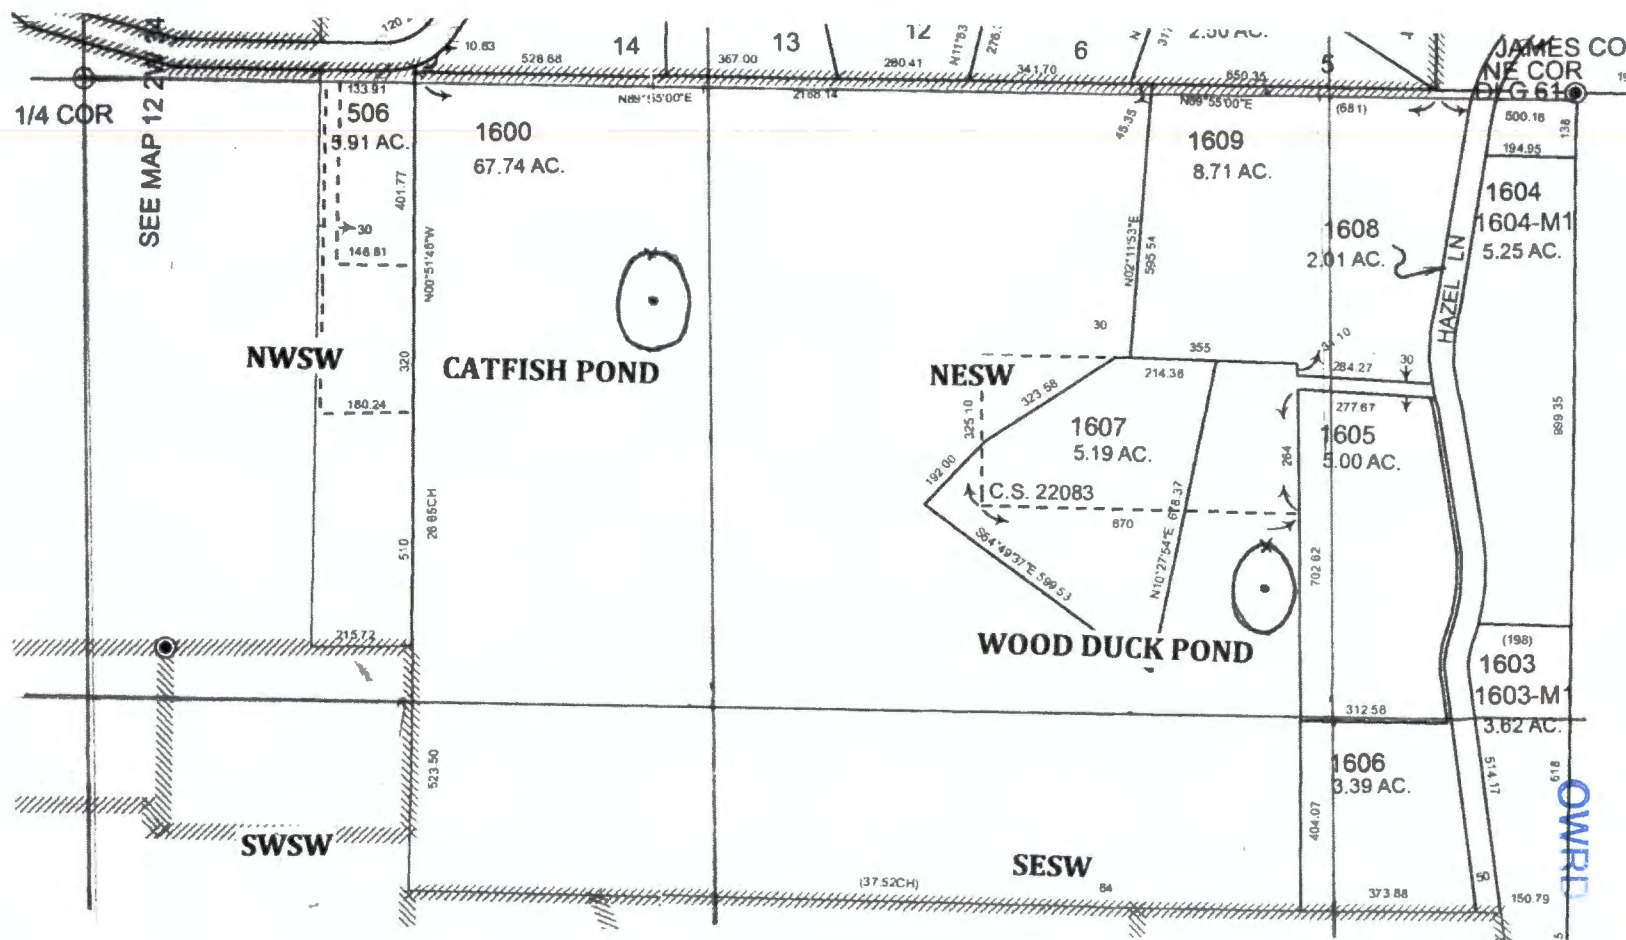

Center of Reservoir

Wood Duck Pond: 1,061 Feet South and 2,517 East from the Reference Corner

Catfish Pond: 459 Feet South and 1,204 Feet East from the Reference Corner

Use: Multipurpose

Reference Corner: NW Corner of the SW Quarter

Dam Location

Wood Duck Pond: 952 Feet South and 2,492 East from the Reference Corner

Catfish Pond: 366 Feet South and 1,253 Feet East from the Reference Corner

