


Township 6 South, Range 32 East, W.M. Sections 33 & 34
Umatilla County

FINAL PROOF MAP
under
Application No. G-15639
Permit No. G-15201
in name of
TERRY TURNER
September 29, 2017

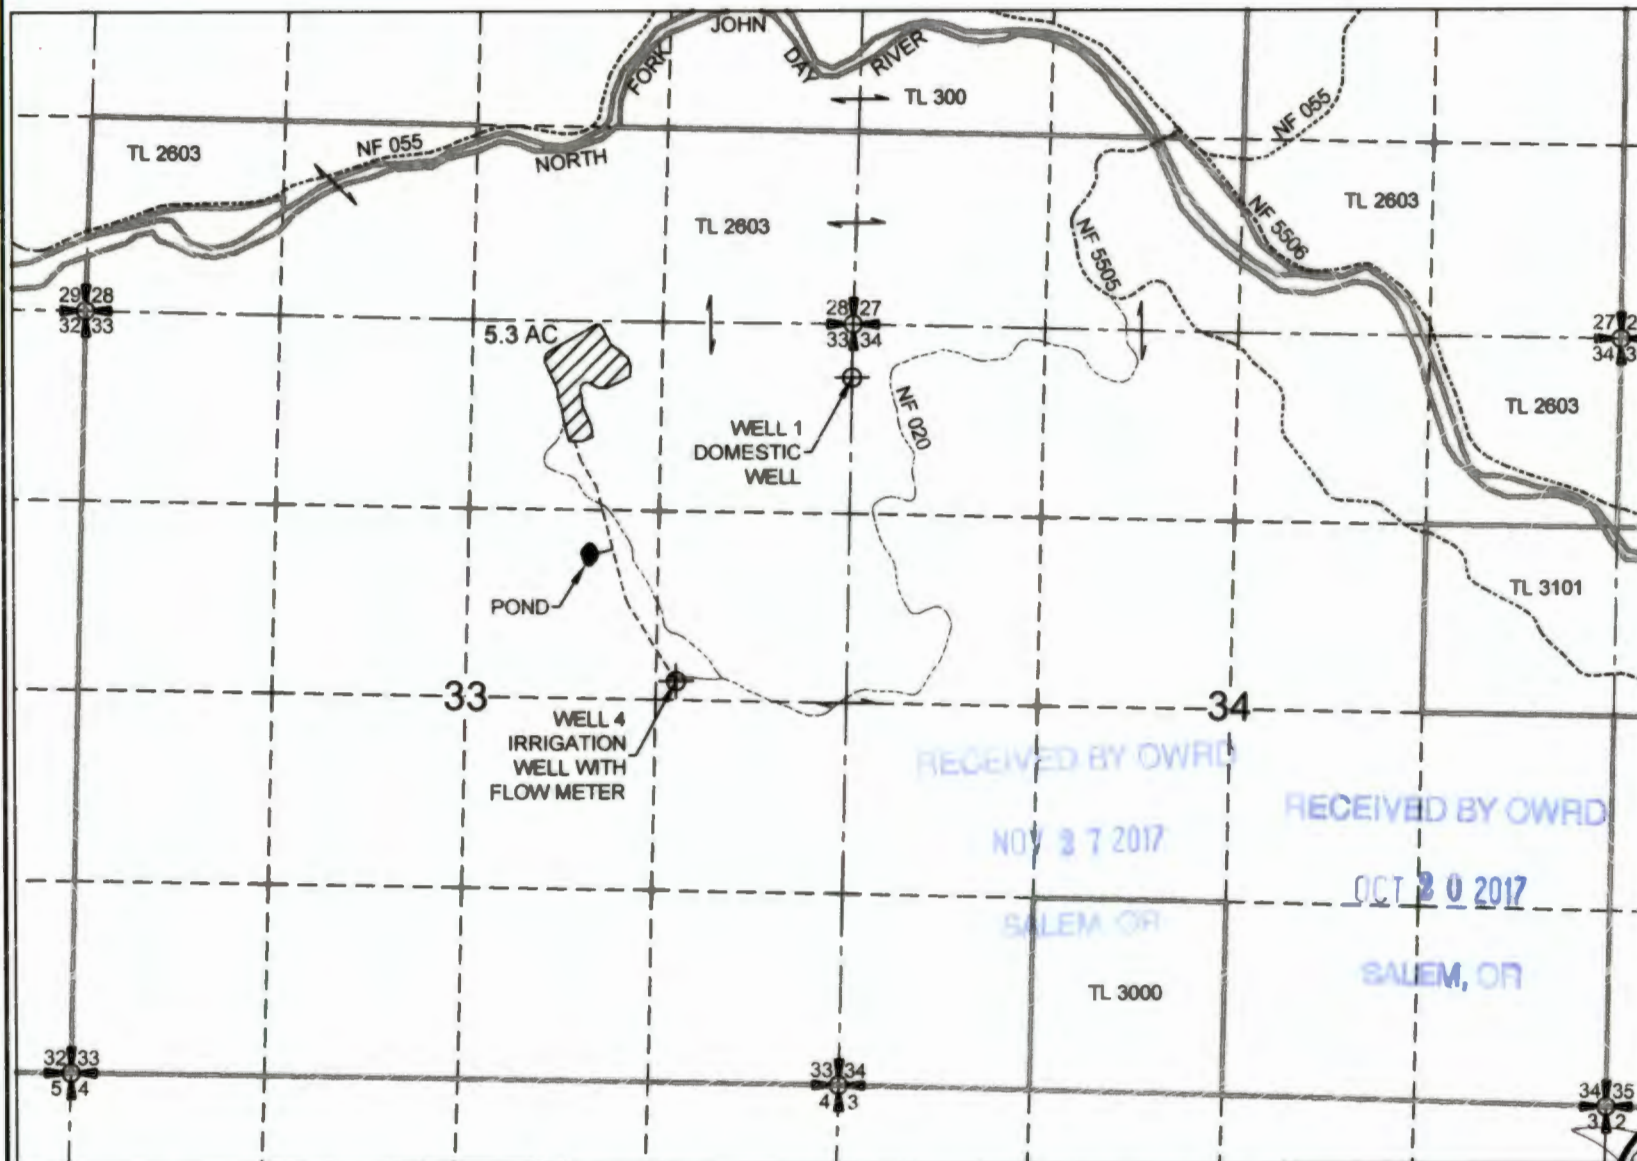

LEGEND

- SECTIONS
- QTR-QTR LINES
- BURIED PIPELINE
- FOREST ROADS
- ⊕ WELLS
- TAX LOTS
- ▨ 5.3 ACRES IRRIGATED




SCALE
1" = 1320'

POA - WELL 4 - IRRIGATION WELL LOCATION: SE $\frac{1}{4}$ NE $\frac{1}{4}$, SECTION 33, T6S, R32E, W.M.; 130 FEET NORTH & 1170 FEET WEST FROM E $\frac{1}{2}$ CORNER, SECTION 33.

POND LOCATION: SW $\frac{1}{4}$ NE $\frac{1}{4}$, SECTION 33, T6S, R32E, W.M.; 1620 FEET SOUTH & 1780 FEET WEST FROM NE CORNER, SECTION 33.

THIS MAP WAS PREPARED FOR THE PURPOSE OF IDENTIFYING THE LOCATION OF A WATER RIGHT ONLY AND IS NOT INTENDED TO PROVIDE LEGAL DIMENSIONS OR LOCATION OF PROPERTY OWNERSHIP LINES.

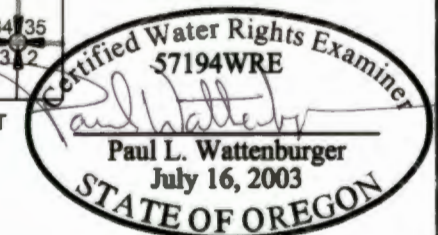

EXPIRES: 6/30/18