


T38S R5W Sec32

RECEIVED

JUN 04 2020

OWRD

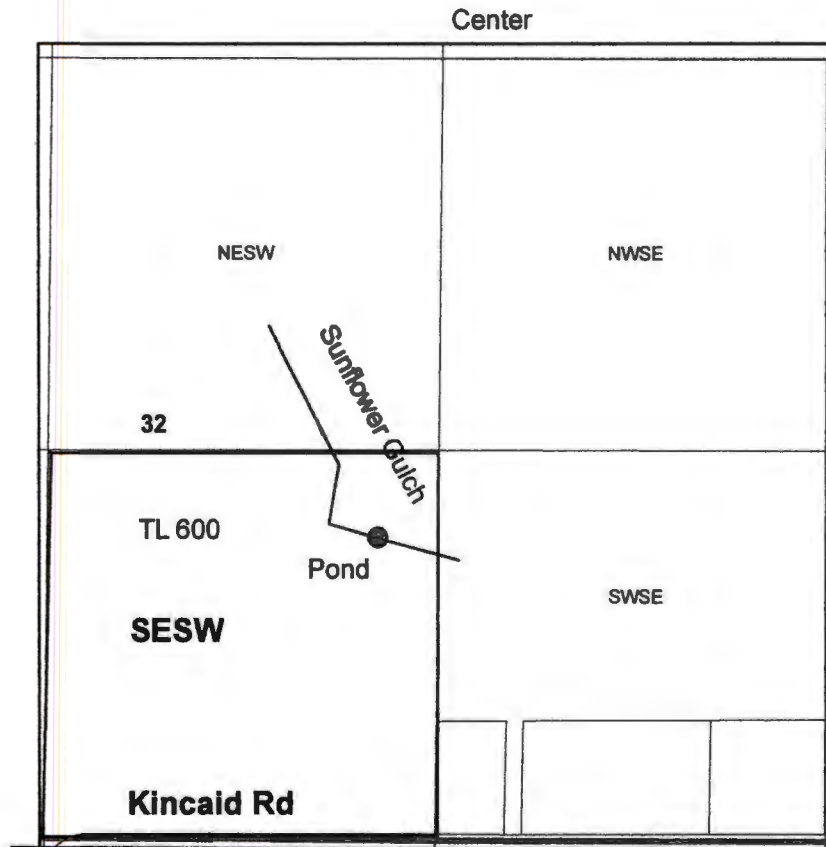

1 inch = 660 feet

Pond is 1646 ft south and 215 ft west from center Sec 32.

RECEIVED BY OWRD
RECEIVED BY OWRD

JUN 12 2015

JUN 01 2015

SALEM, OR

SALEM, OR

R-88027 R-5140