

Wayne and Amanda Staehely

1" = 1320'

Tax Lot:

Township 4 South, Range 1 East, Section 34, Tax Lot 1100, 1101

AUG 23 2016


SALEM, OR



North

MAY 15 2017

SALEM, OR

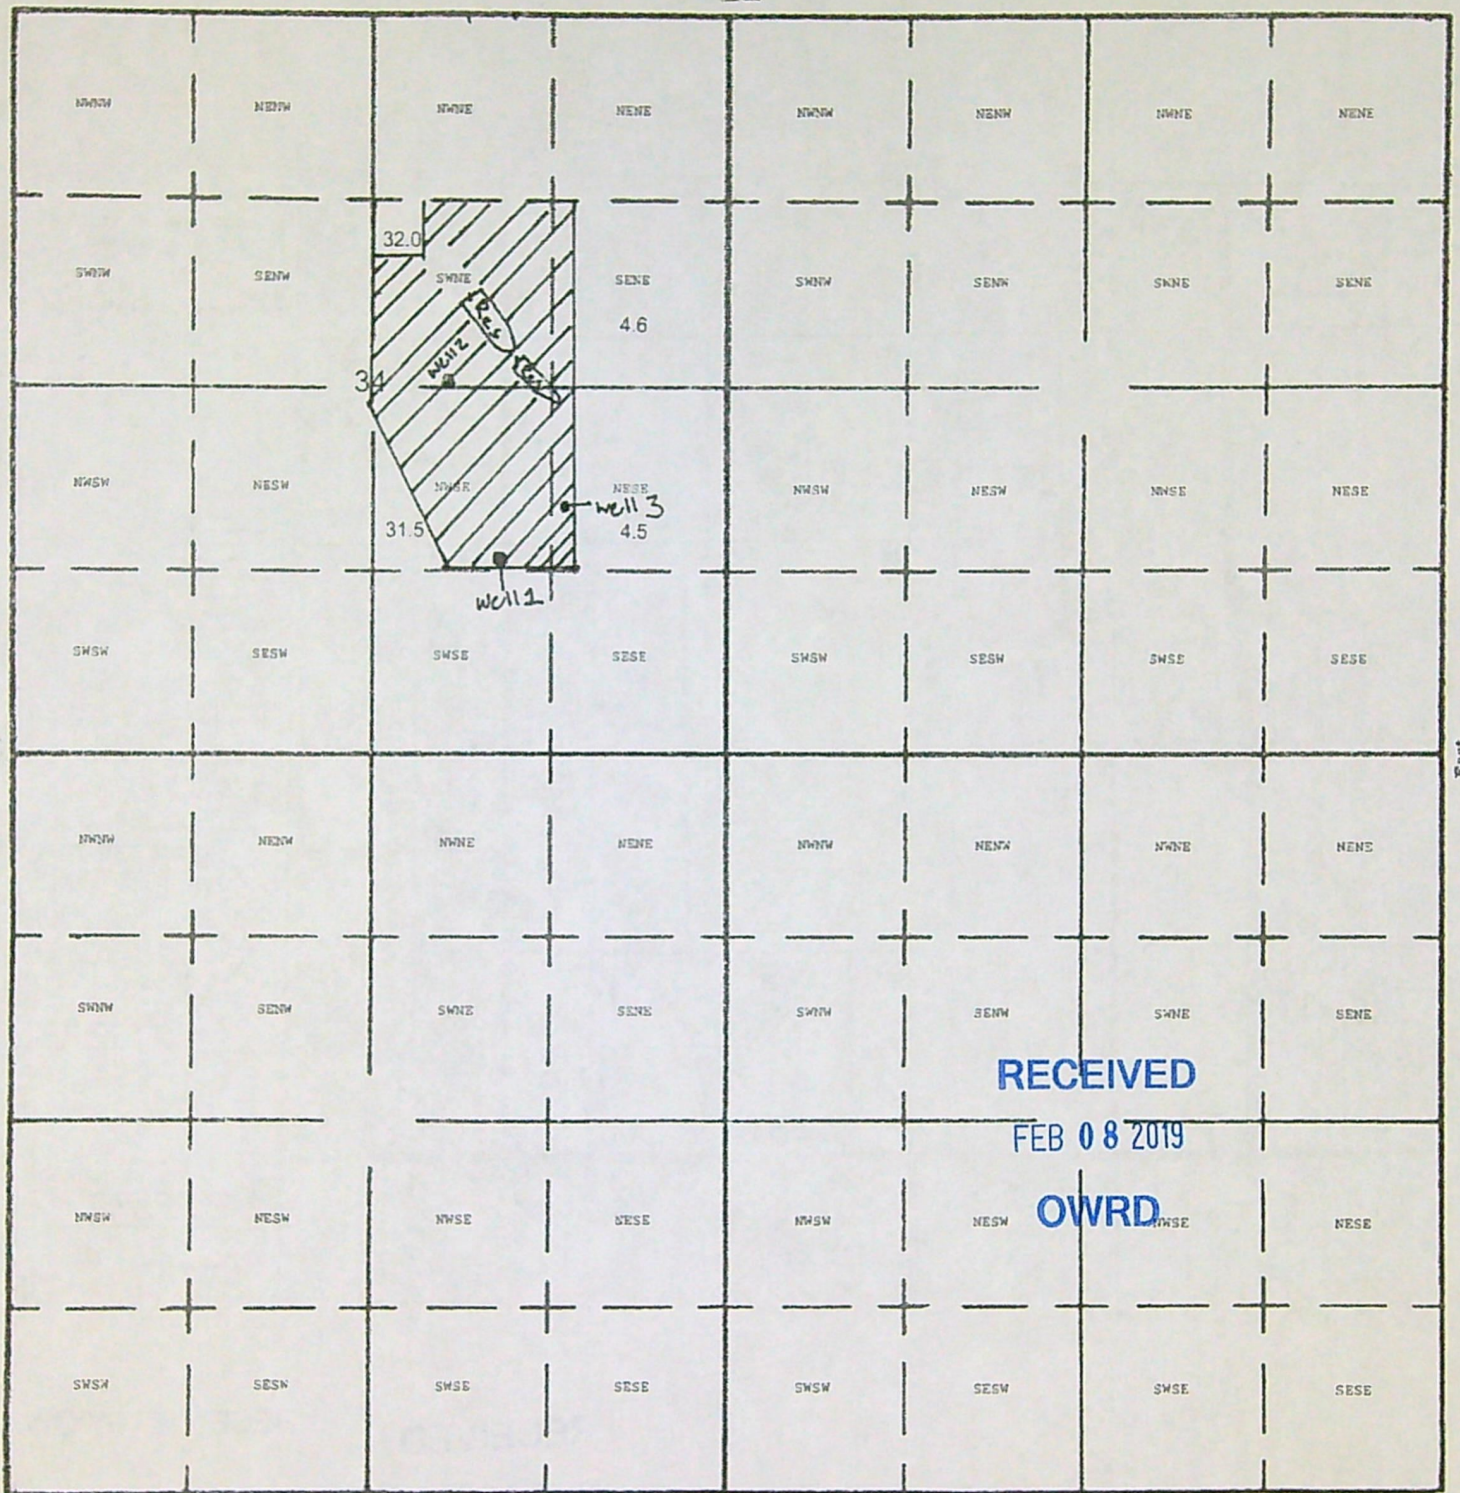

Well #1: (CLAC 12773) 3950 Feet South and 1665 Feet West from the NE Corner Section 34 Lat 45.17617 Long -12266757
Well #2: (CLAC 72276) 2100 Feet South and 2110 Feet West from the NE Corner Section 34
Well #3 Proposed Well: 3545 Feet South and 1200 Feet West from the NE Corner Section 34
North Dam #1: 1890 Feet South and 2050 Feet West from the NE Corner Section 34
North Dam #2: 2455 Feet South and 1600 Feet West from the NE Corner Section 34

Wayne and Amanda Staehely