

RECEIVED

JAN 0 4 2019

OWRD


RECEIVED

FEB 1 1 2000

WATER RESOURCES DEPT.  
SALEM, OREGON

1" = 200'

O = 5/8" DIA. IRON PIN

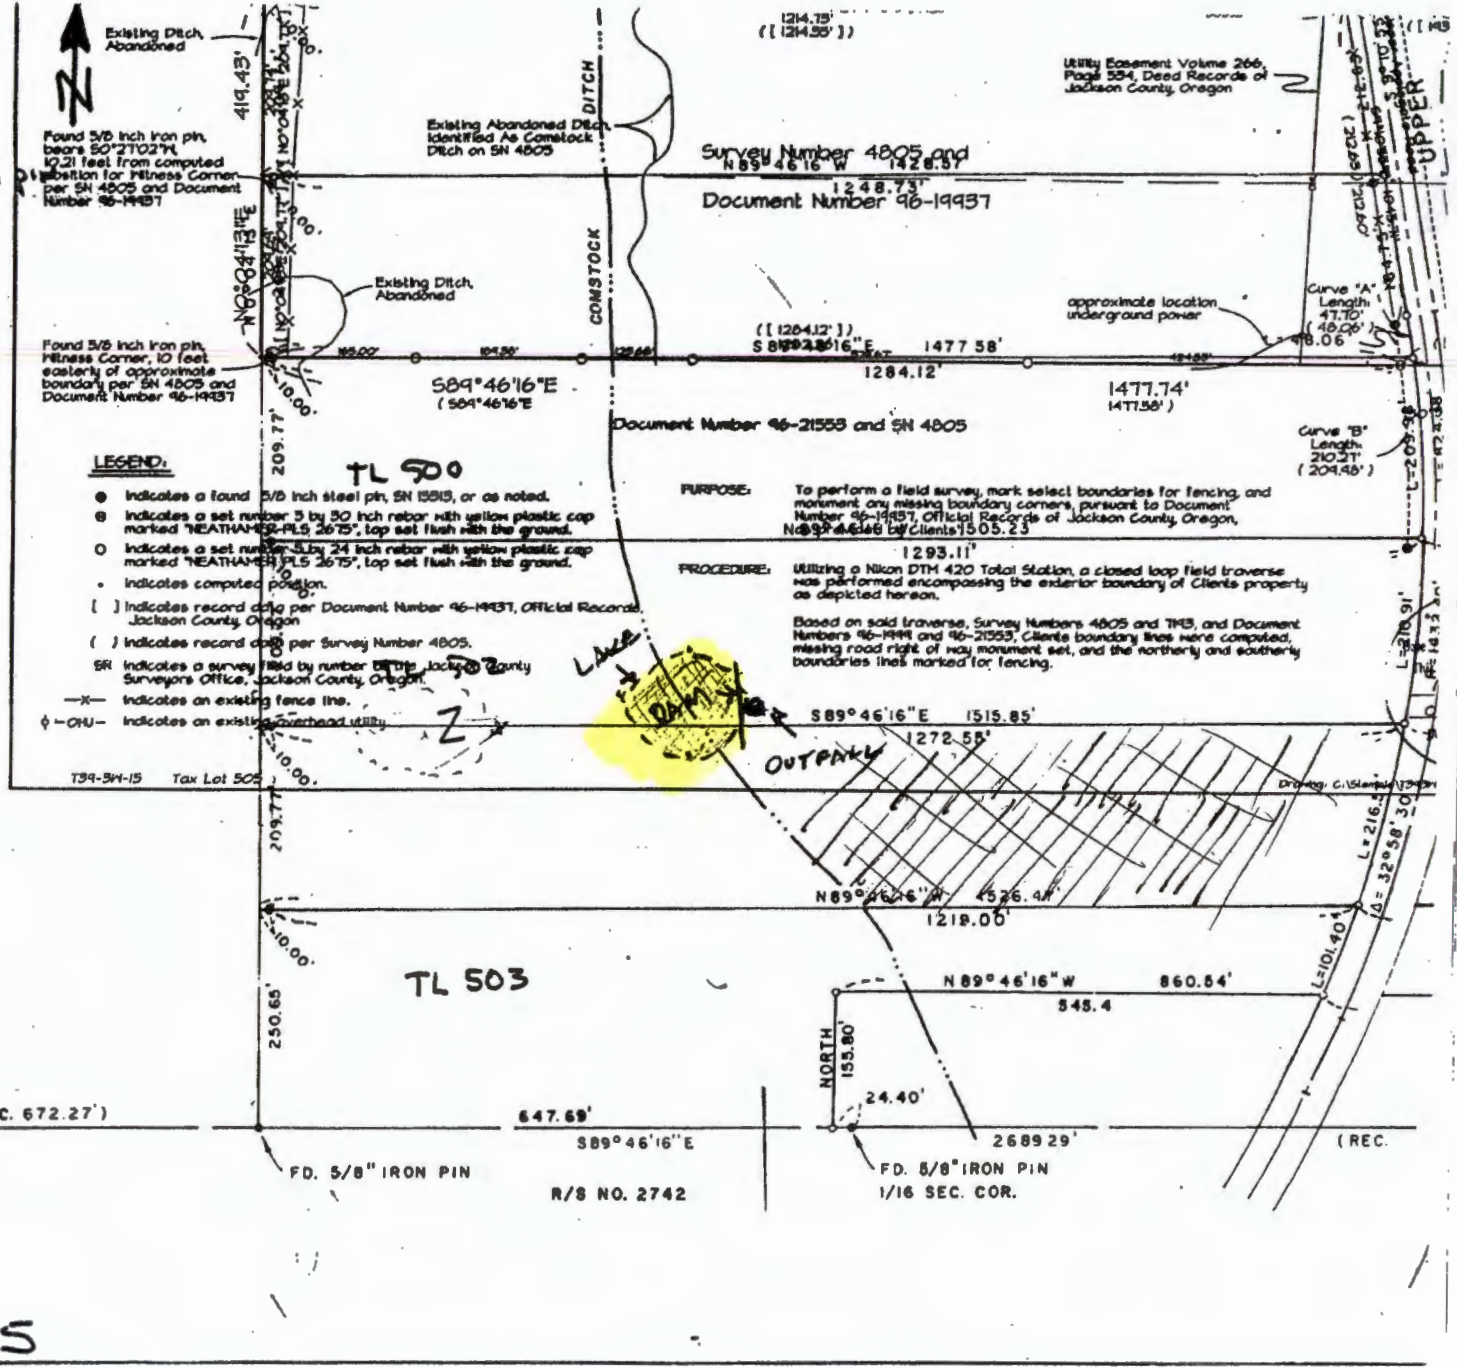

SN 4805