


SECTIONS 19 & 30, TWP.2 N. RANGE 20 E. W.M. GILLIAM COUNTY, OREGON

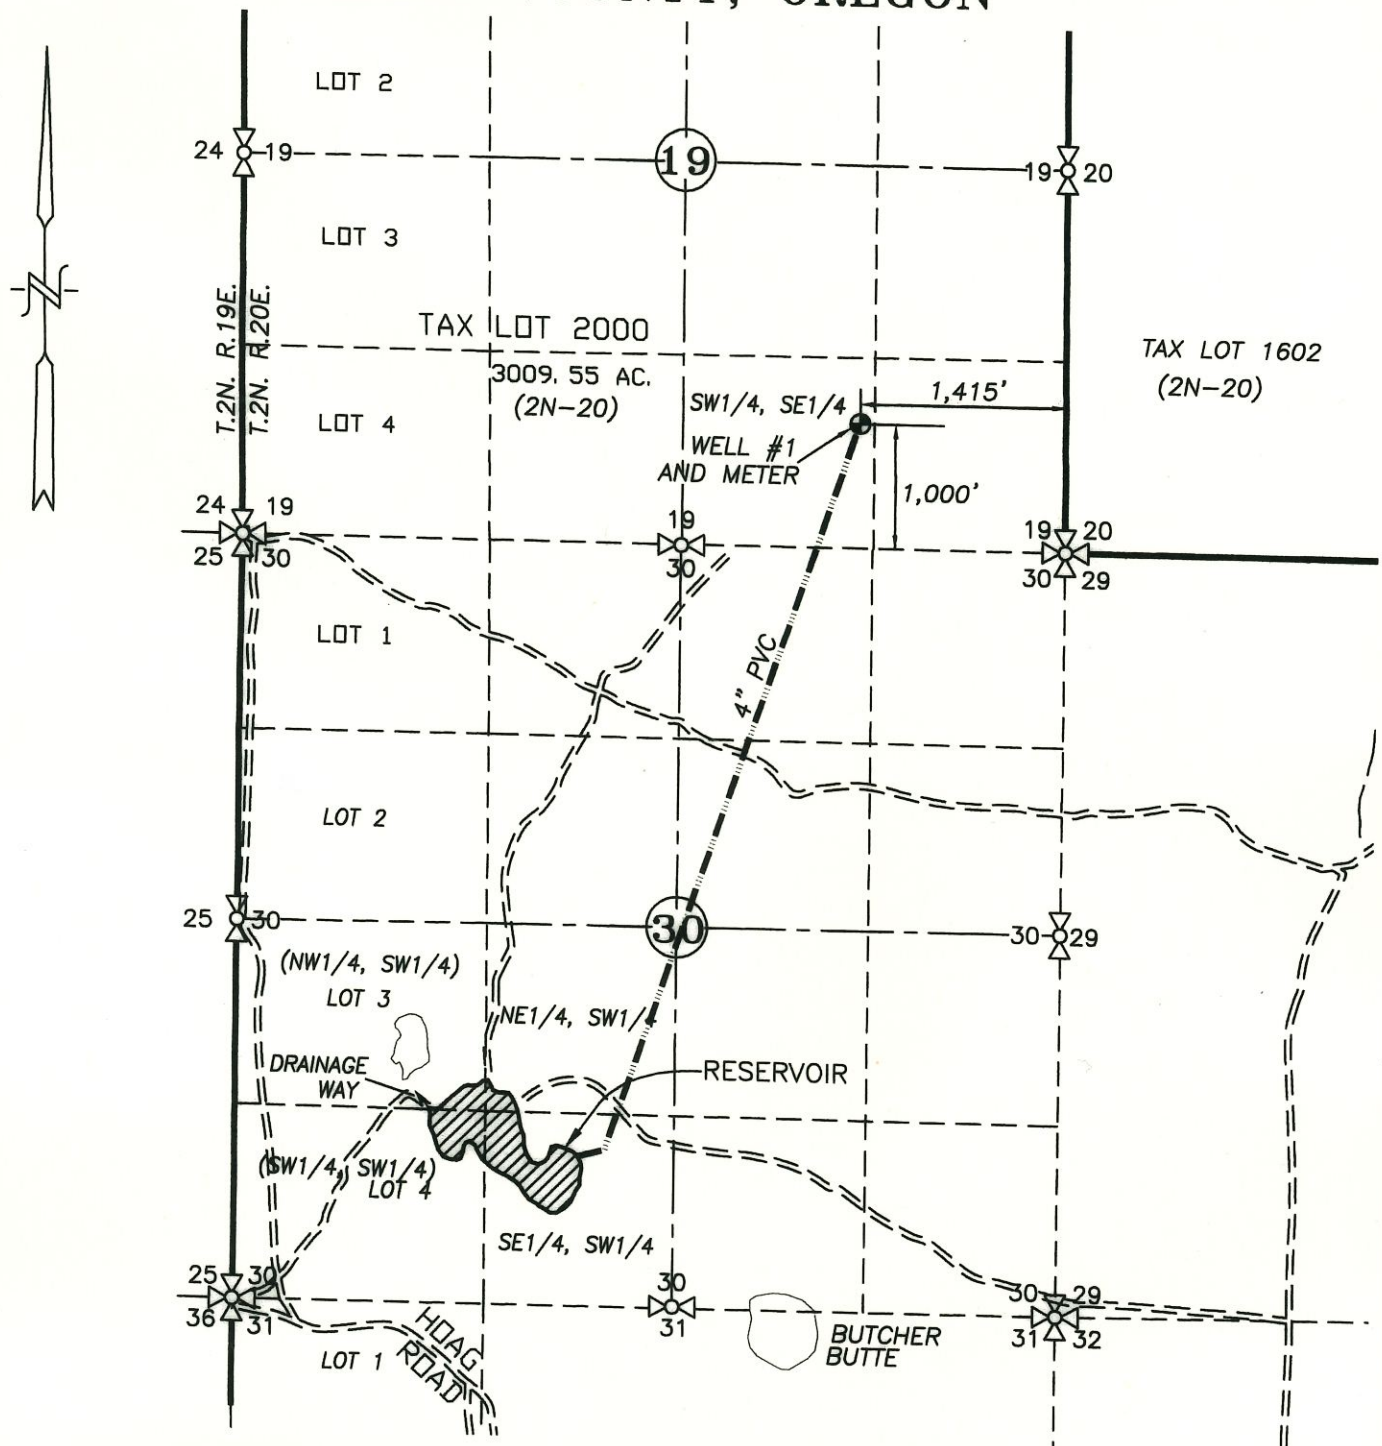

● EXISTING WELL #1 (GILL 105): 1,000' N. & 1,415' W. OF SE COR. SEC. 19
RESERVOIR: 1,345' N. & 1,340' E. OF THE SW CORNER SECTION 30

RESERVOIR = 9.75 ACRES (SURFACE AREA)

— WATER LINE

CLAIM OF BENEFICIAL USE MAP

SCALE: 1" = 1320'
0' 660' 1320' 2640'

APPLICATION No. G-16231

PERMIT No. G-15802

IN THE NAME OF:

JOHN DAY RIVER CLUB, LLC

DATE: DECEMBER 6, 2018

BY: **TENNESON ENGINEERING CORP.**

3775 CRATES WAY
THE DALLES, OREGON. 97058
PH. 541-296-9177
FAX 541-296-6657



EXPIRES: 06/30/2020

NOTE:

"THIS MAP IS NOT INTENDED TO PROVIDE
LEGAL DIMENSIONS OR LOCATIONS OF
PROPERTY OWNERSHIP LINES."

W.O. #11153wr

COBU MAP 1167