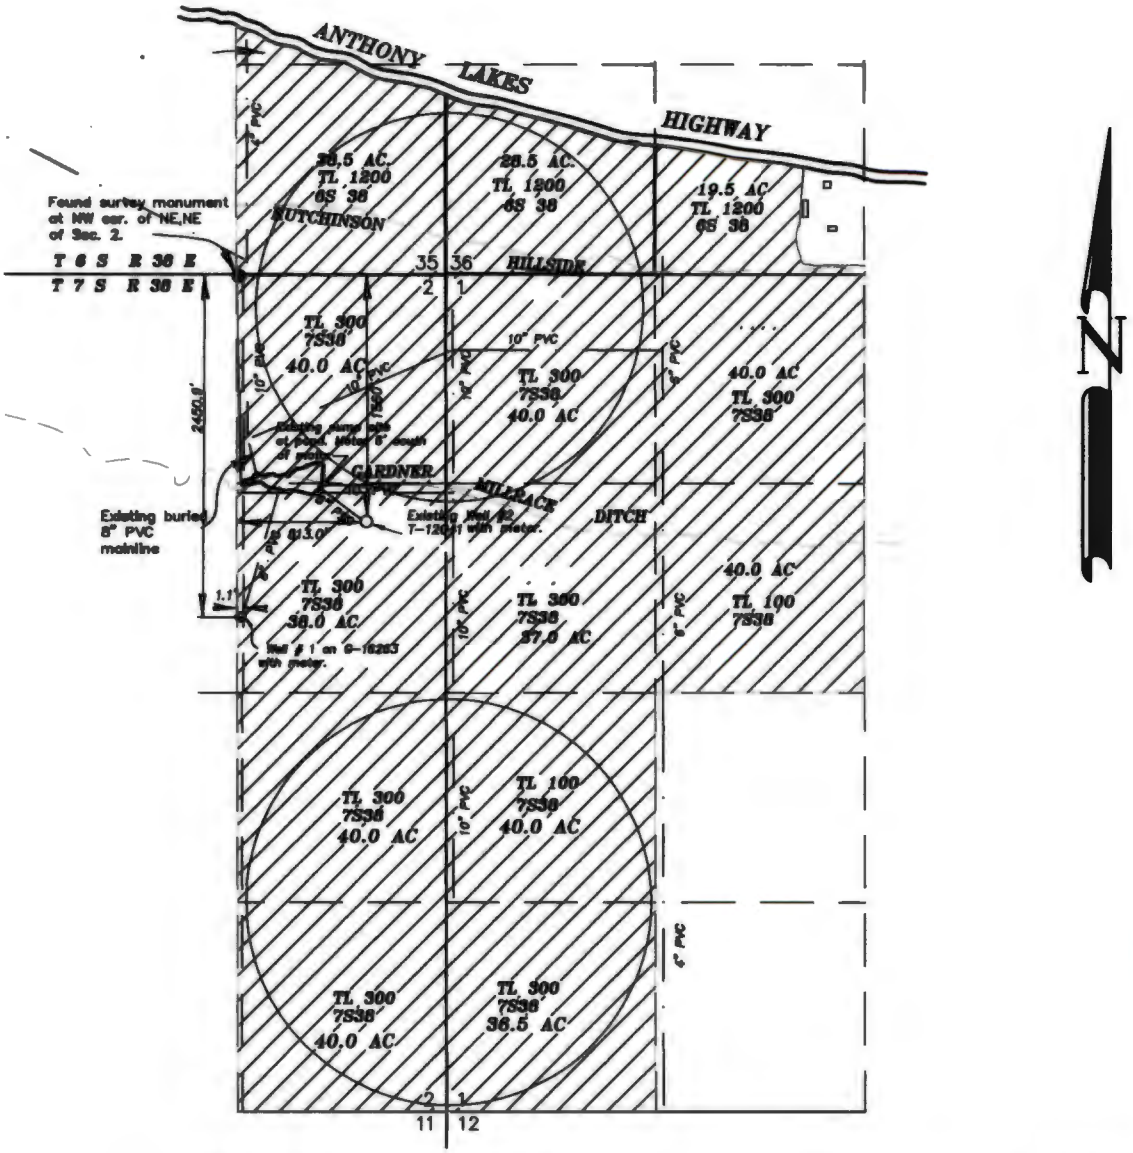

SCALE: 1"=1320'

Lands requesting Supplemental water from new Wells #1 and #2 under Permit T-12041 and having primary water under C-1470, C-1471, and C-1455.

Well # 1 Located S 2450.9 & E 1.1' from Monument at the NW cor of the NE, NE. Latitude: 44°59'07.81165"N, Longitude 118°01'06.78391" W

Well # 2 Located authorized position: 1560' S, 813' E from NW corner of NE, NE, Sec. 2
Latitude: 44°59'15.63079" N,
Long: 118°00'48.91702" W

RECEIVED
JUL 13 2018
OWRD

Certified Water Right Examiner
021
Gregory T. Blackman
Nov. 19, 1987
STATE OF OREGON

AUGUST 7, 2017

CLAIM OF BENEFICIAL USE MAP FOR PLERMIT G-16263 AND PERMIT AMENDMENT T-12041

FOR

LOUIS MARKS

BY

BAGETT - GRIFFITH & BLACKMAN
126 RIDGE DRIVE
LAGRANDE, OREGON 97850

Application No. G-16798
Permit Number G-16263 & T-12041

NOTE: The preparation of this map was for the purpose of identifying the location of the proposed water right and has no intent to provide dimensions or location of property ownership lines. Location information shown hereon was furnished by the applicant.