CLAIM OF BENEFICIAL USE MAP

FOR: BONNY WALLACE (DECEASED)
ANNIKA MOSIER (TRUSTEE)
BY: NATHAN R. REED, P.E., CWRE
T26S, R5W, W.M. SECTION 30
APPLICATION NO. S-86597
PERMIT NO. S-54418
DATE SURVEYED: SEPTEMBER 21, 2016

N
W E
S
Scale: 1" = 400'

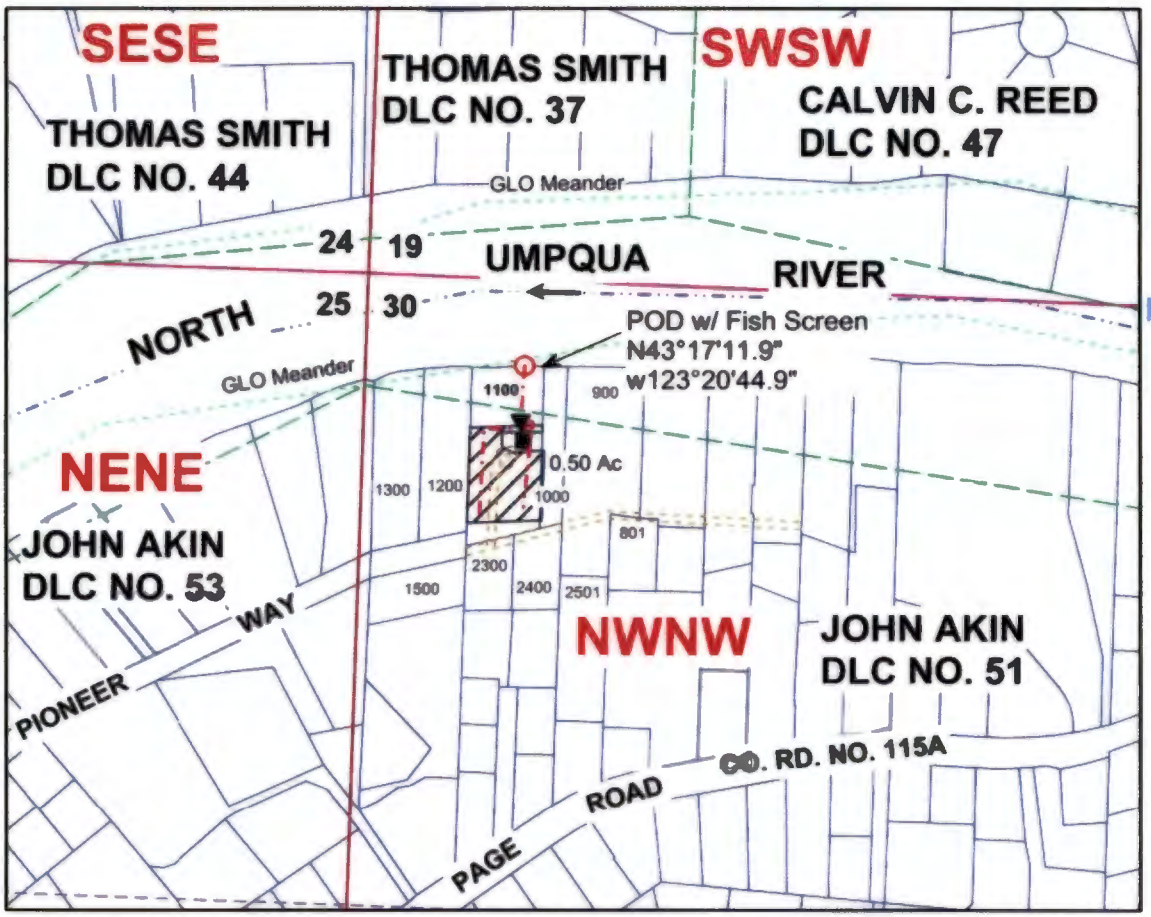

POD LOCATED 290 FEET EAST AND 190 FEET SOUTH OF THE NW CORNER OF SECTION 30

RECEIVED BY OWRD
NOV 07 2016
SALEM, OR

RECEIVED BY OWRD
OCT 06 2016
SALEM, OR

Legend

River		Irrigation		DLC	
Flow Arrow		Private Drive		Section	
POD		Structure		Sixteenth	
Pump		Meander		Parcels	

MAP PREPARED FOR:
ANNIKA MOSIER
3446 WILLOW STREET
DENVER, CO 80238

Certified Water Right Examiner
58245
Nathan Reed
NATHAN R. REED
May 3, 2011
9-25-16
STATE OF OREGON
Expires Dec. 31, 2016

THE PURPOSE OF THIS MAP IS TO IDENTIFY THE LOCATION OF THE WATER RIGHT. IT IS NOT INTENDED TO PROVIDE INFORMATION RELATIVE TO THE LOCATION OF PROPERTY OWNERSHIP BOUNDARY LINES.

MAP PREPARED BY:
NATHAN R. REED, P.E., CWRE
1113 SE CASS AV
ROSEBURG, OR 97470