


CLAIM OF BENEFICIAL USE MAP

FOR: JOHN & RAQUEL O'CONNOR
 BY: NATHAN R. REED, P.E., CWRE
 T26S, R2W, W.M. SECTION 17
 APPLICATION NO. S-86514
 PERMIT NO. S-54349



DATE SURVEYED: SEPTEMBER 10, 2016

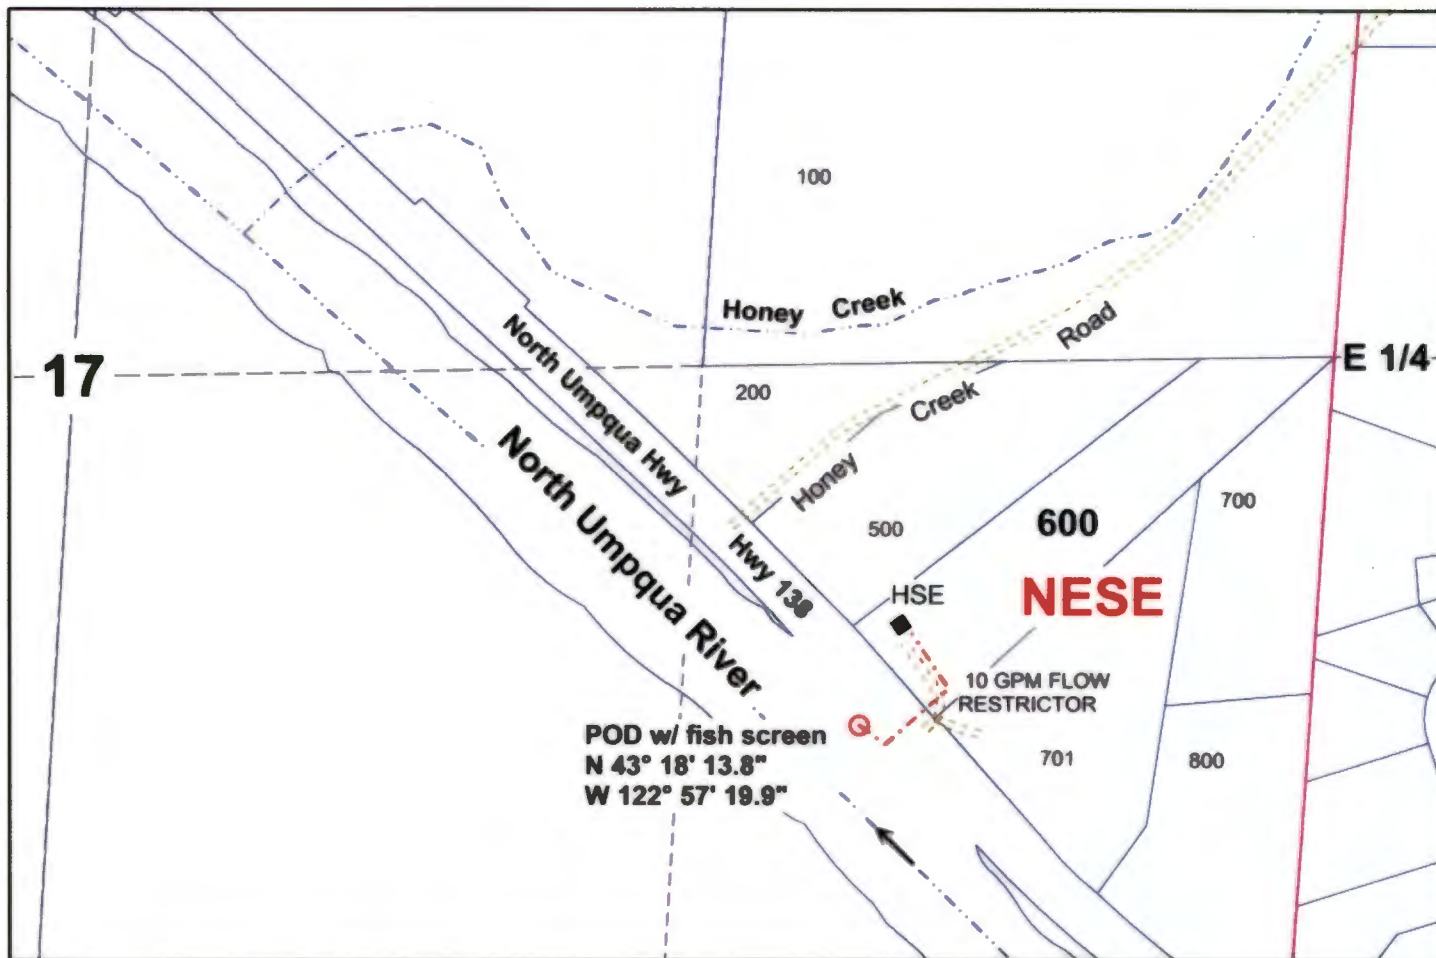


POD IS LOCATED 750 FEET SOUTH AND 975 FEET WEST FROM THE E 1/4 OF SECTION 17.

Legend

- POD
- - - - - Pipeline
- Structure
- - - - - Roads
- · - · - Stream
- Flow arrow
- Section
- Parcels
- - - - - Quarter
- - - - - Sixteenth

MAP PREPARED FOR:
 JOHN & RAQUEL O'CONNOR
 28658 N. UMPQUA HWY
 IDLEYLD PARK, OR 97447

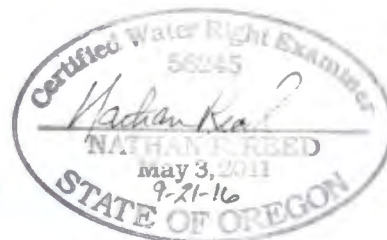

RECEIVED BY OWRD

OCT 03 2016

SALEM, OR

THE PURPOSE OF THIS MAP IS TO IDENTIFY THE LOCATION OF THE WATER RIGHT. IT IS NOT INTENDED TO PROVIDE INFORMATION RELATIVE TO THE LOCATION OF PROPERTY OWNERSHIP BOUNDARY LINES.

MAP PREPARED BY:
 NATHAN R. REED, P.E., CWRE
 1113 SE CASS AV
 ROSEBURG, OR 97470