

Claim of Beneficial Use


APPLICATION S-86499

PERMIT S-54326

TOWNSHIP 26 S., RANGE 3 W., W.M. - SECTION 9

DOUGLAS COUNTY, OREGON

Assessor Map # T-26S, R3W-9D

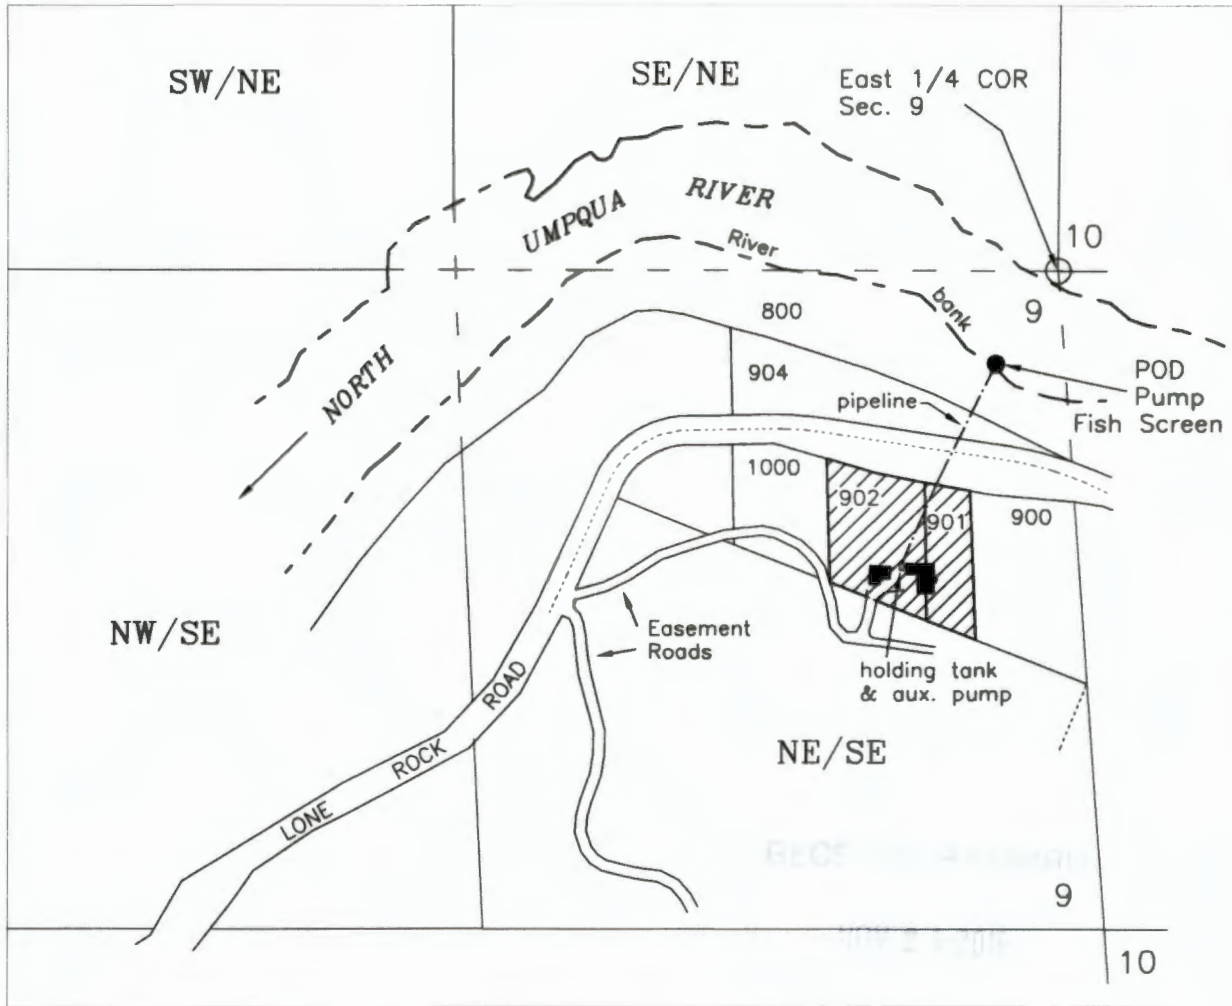

POD - NE/SE, Section 9, 195 feet South & 130 feet West from the E 1/4 Corner, Section 9




Domestic Use Expanded (year round)
for one household



House

PREPARED FOR:
Kerry & Gloria Quilhaugh
1605 Lonerock Road
Glide, OR 97433

Scale
1" = 400'

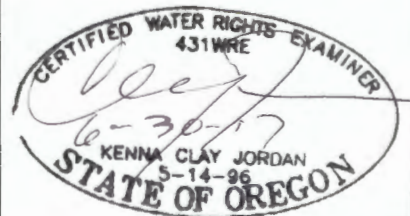

JORDAN ENGINEERING

460 JORDAN LANE
ROSEBURG, OREGON 97471
(541) 673-1931

Base map - Recorded Survey M127-48, Douglas Co. GIS tax lots, over 10/28/2016 Oregon Map aerial photo & 7/15/2015 Google aerial photo for assumed best fit. Map scaled and oriented to M 127-48 survey

This map is not intended to provide legal dimensions or locations of property ownership lines

10/27/2016 n.e.d.