

CLAIM OF BENEFICIAL USE MAP

FOR
CHARLES K. KELLEY


SECTIONS 7 & 18
TOWNSHIP 39 SOUTH RANGE 19 EAST,
LAKE COUNTY, OREGON

RECEIVED
JAN 22 2019

OWRD

RECEIVED BY OWRD


OCT 27 2014
SALEM, OR

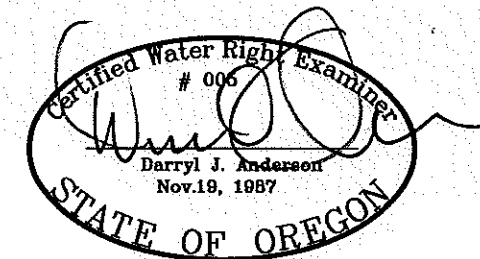

RENEWAL 12/31/15

LEGEND


- SECTION LINE
- 1/4 SECTION LINE
- 1/16 SECTION LINE
- IRRIGATION MAIN LINE
- DISTRIBUTION DITCH
- IRRIGATION

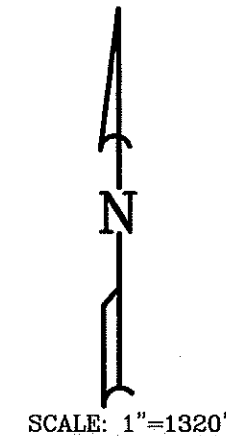

APPLICATION NO. S-87775

PERMIT NO. S-54800

NOTE:
PREPARATION OF THIS MAP IS FOR IDENTIFYING PROPOSED
WATER RIGHTS ONLY. IT HAS NO INTENT TO PROVIDE
LOCATIONS OR DIMENSIONS OF PROPERTY BOUNDARIES.

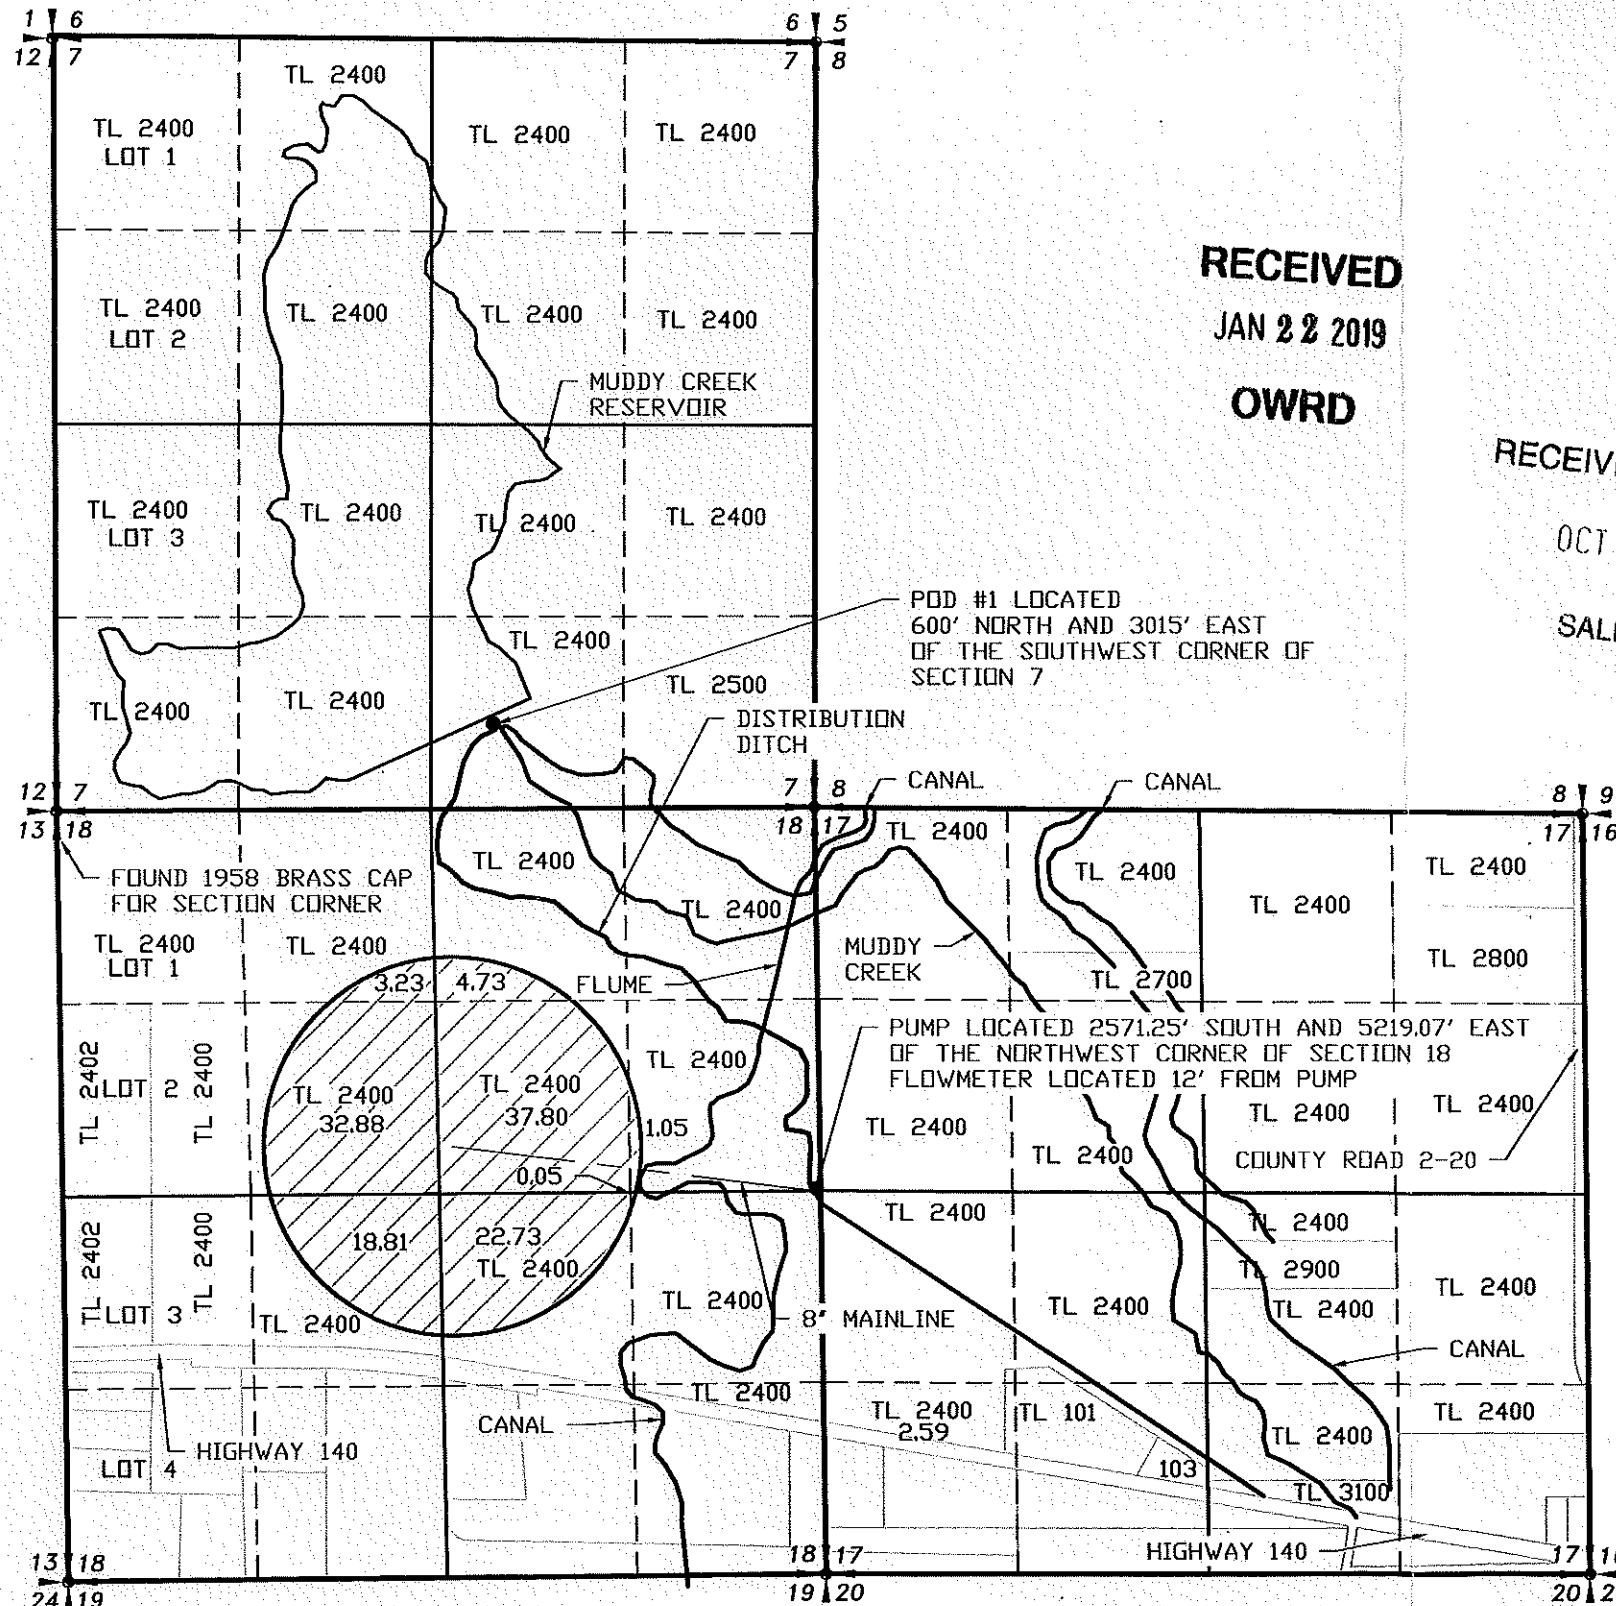

CORR MAP # 864

REVISION	BY

**ANDERSON ENGINEERING
AND SURVEYING, INC.**
P.O. BOX 28
LAKEVIEW, OREGON 97630
(541) 947-4407
FAX: 947-2321

FOR:
CHARLES K. KELLEY
P.O. BOX 711
LAKEVIEW, OR 97630
541-947-3000

CLAIM OF BENEFICIAL USE MAP
PERMIT S-54800
CHARLES K. KELLEY

DATE:	12/13/11
SCALE:	1"=1320'
DWG. BY:	R.C.
JOB:	2011-115
FILE:	2011-115
SHEET:	1 OF 1