

Application for George Gover to change the Place of use


# Certificate 80372 & 67383 & 27737 SUP

## Township 8 S, Range 46 E Sec 20




RECEIVED BY OWRD


OCT 25 2012

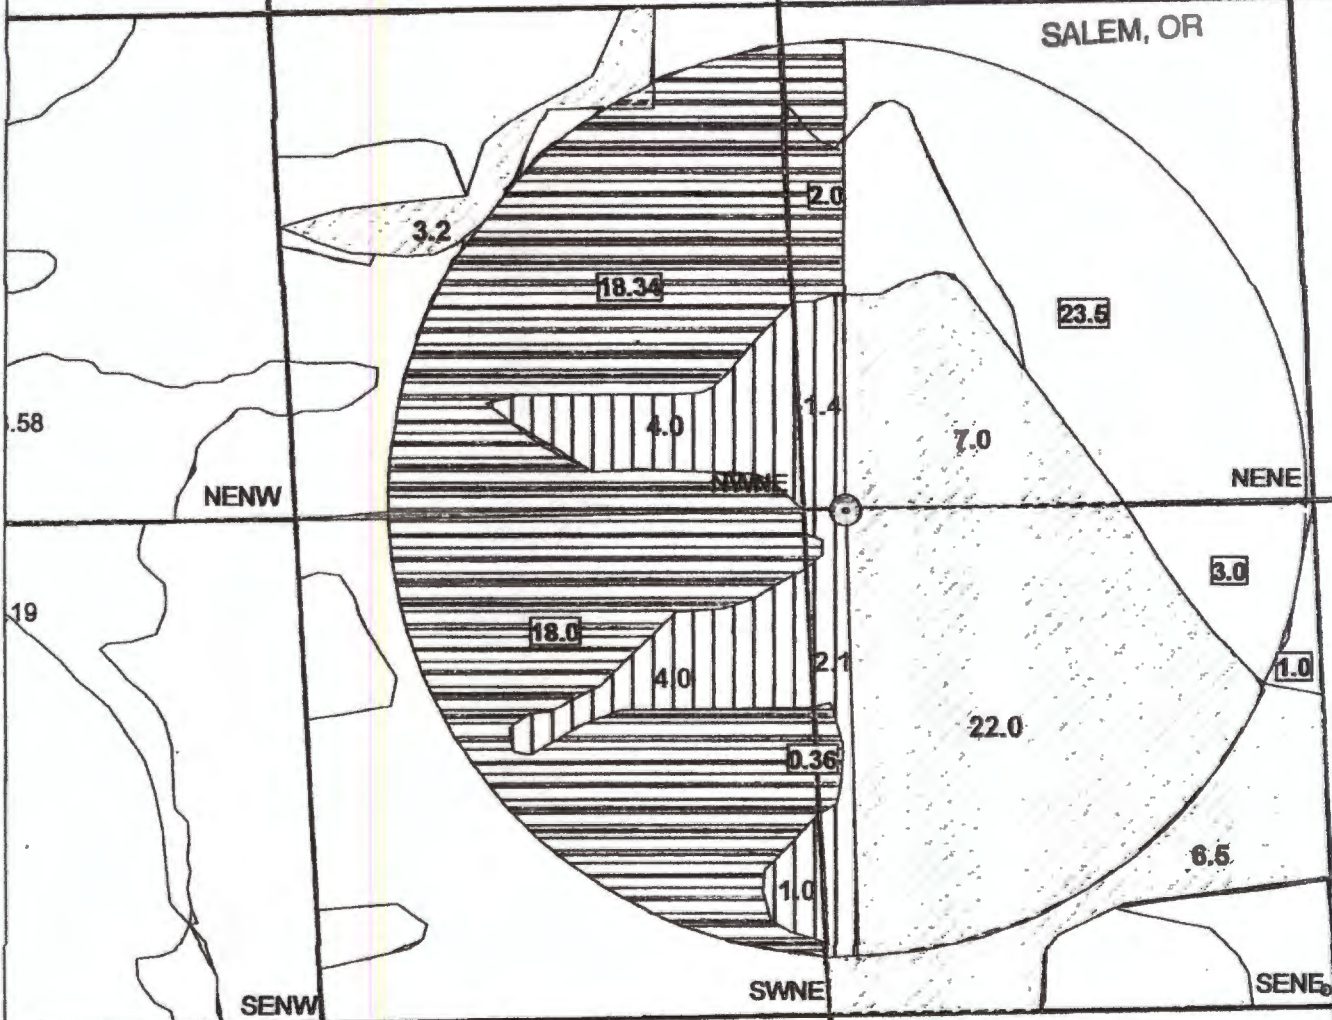SALEM, OR



**Legend** 1 inch = 500 feet

-  80372 67383 27737 "From"
-  80372 67383 27737 Remaining
-  80372 67383 27737 "TO"

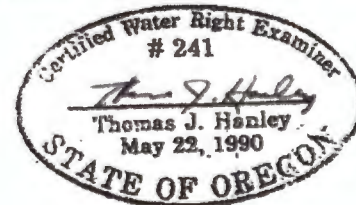

This product is for informational purposes and may not have been prepared for, or be suitable for legal, engineering, or surveying purposes. Users of this information should review or consult the primary data and information sources to ascertain the usability of the information.