


vis N. 48° 45' E. 1942' from

E-97
958

(at 185' apt. 830' E. of
+ Cor. between 28-32)

Terminus.

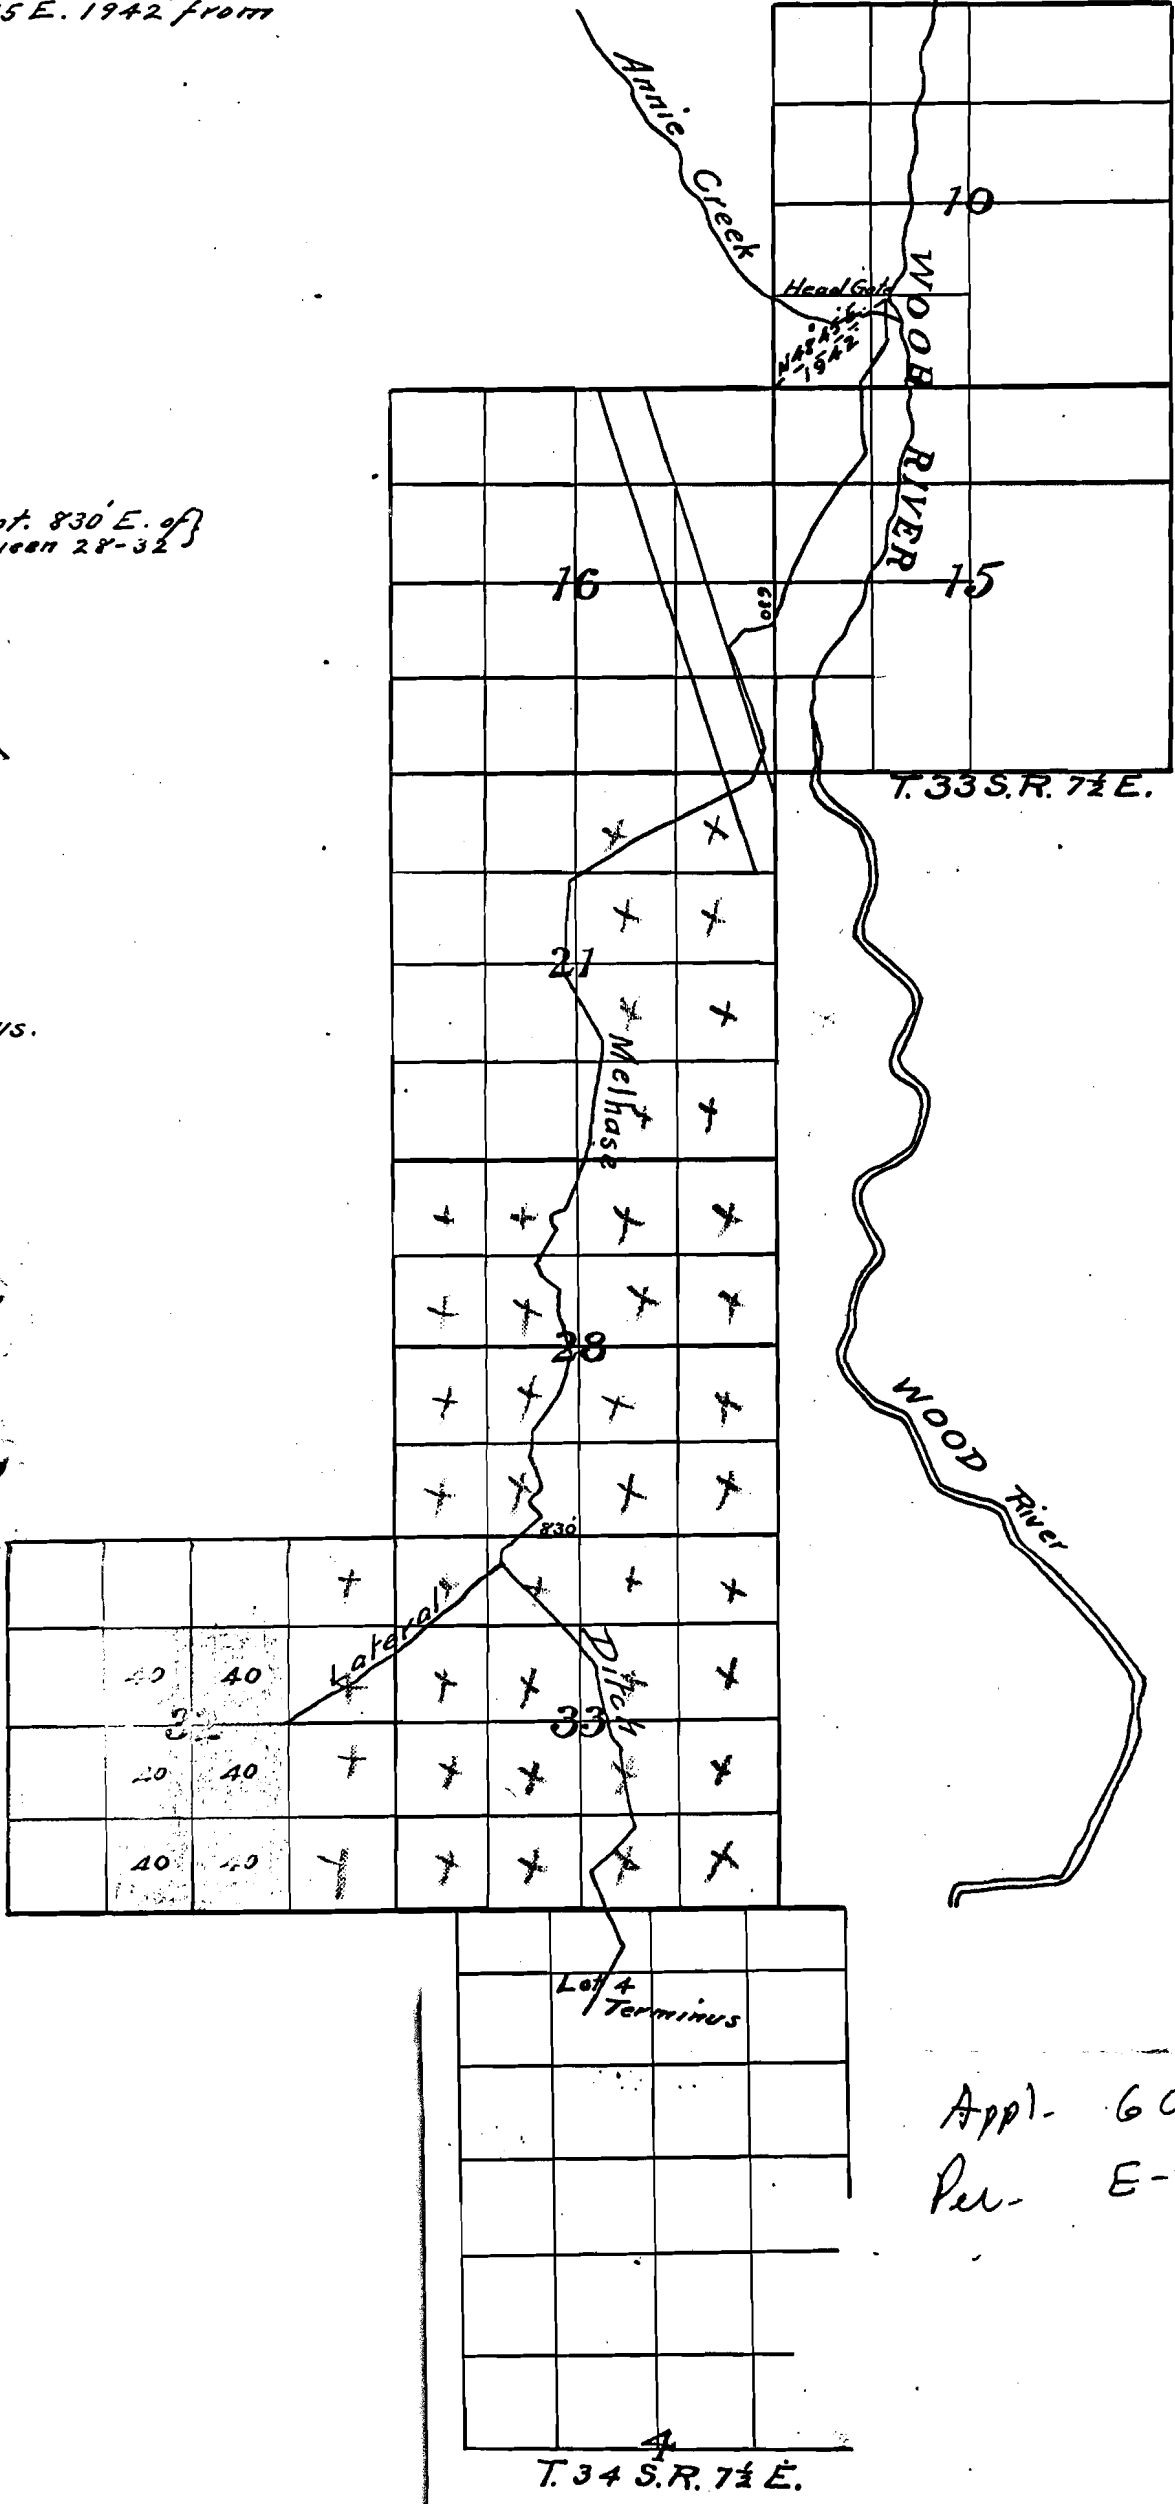

Appl. 609
Per. E-97

T. 34 S. R. 7 1/2 E.