

SCALE: 1" = 1320'

FINAL PROOF SURVEY
 UNDER
APPLICATION NO. T-11975
SPECIAL ORDER VOL. 101, PAGE 293
 IN NAME OF
MARY ELLEN BROOKS


RECEIVED BY OWRD

SEP 15 2017

SALEM, OR

PREPARED BY
 ROBERT D. BAGETT, PLS, CWRE
 217 N. CANYON BLVD.
 JOHN DAY, OREGON
 (541) 575-1251

SEPT. 11, 2017

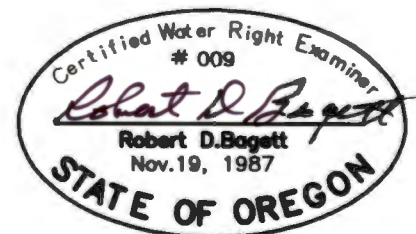

RENEWS: 12/31/2017

○ POD 1990' NORTH & 1430' WEST FROM SE COR. SEC. 24
PUMP, METER & FISH SCREEN AT POD

PLACE OF USE

----- MAIN LINE

() TAX LOT NO.

DISCLAIMER: THIS MAP IS NOT INTENDED TO PROVIDE LEGAL DIMENSIONS OR LOCATION OF PROPERTY OWNERSHIP LINES