


RECEIVED

NOV 18 1982

WATER RESOURCES DEPT.
SALEM, OREGON

Donald Bieberstedt
Application Nos. 26037 & R-26036
Permit Nos. 20560 & R-1222
June 13, 1951
Municipal and Industrial Water Co., Misc.
Vol. 5

~~Sheet 4 22992 + 22994~~

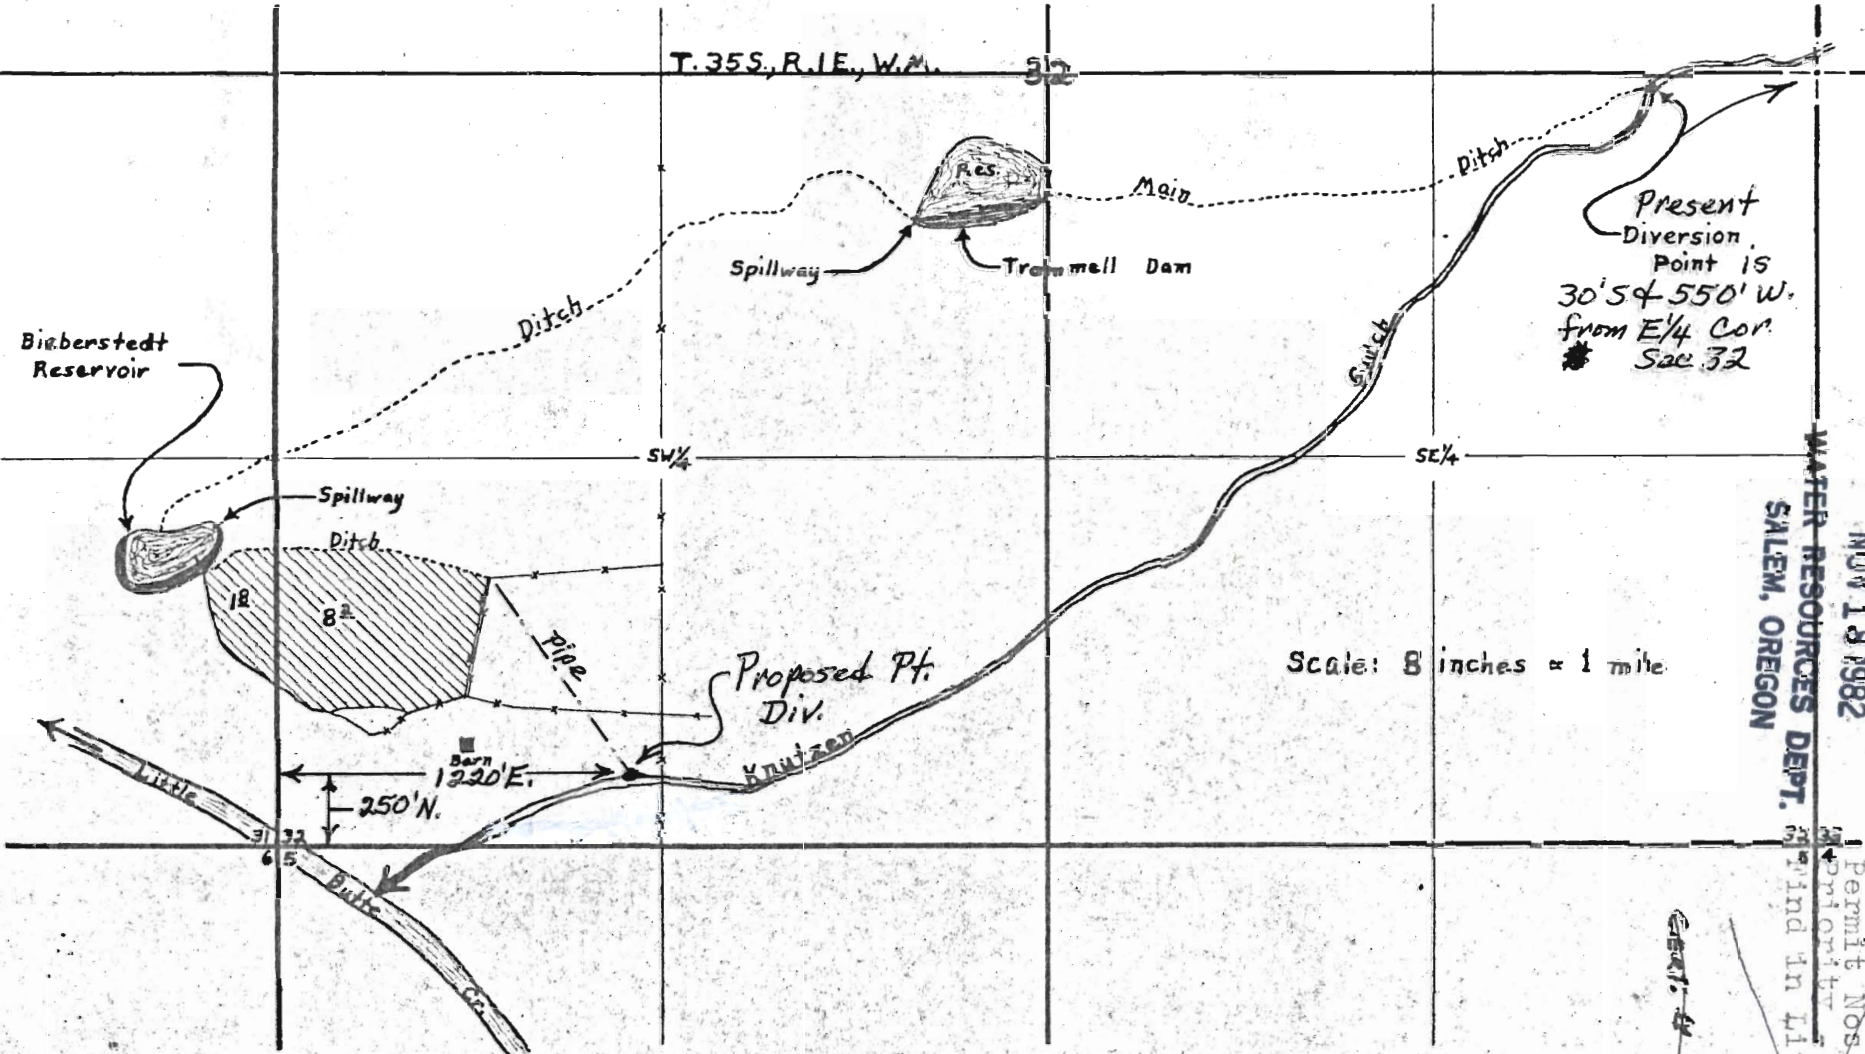

FINAL PROOF SURVEY
UNDER
Application No. R-26036 26037 Permit No. R-1222 20560
IN NAME OF

Donald Bieberstedt

Surveyed April 3, 1957, by D.C. Hendrix, W.M.

T-5161