


TOWNSHIP 18 SOUTH, RANGE 1 WEST, W.M.

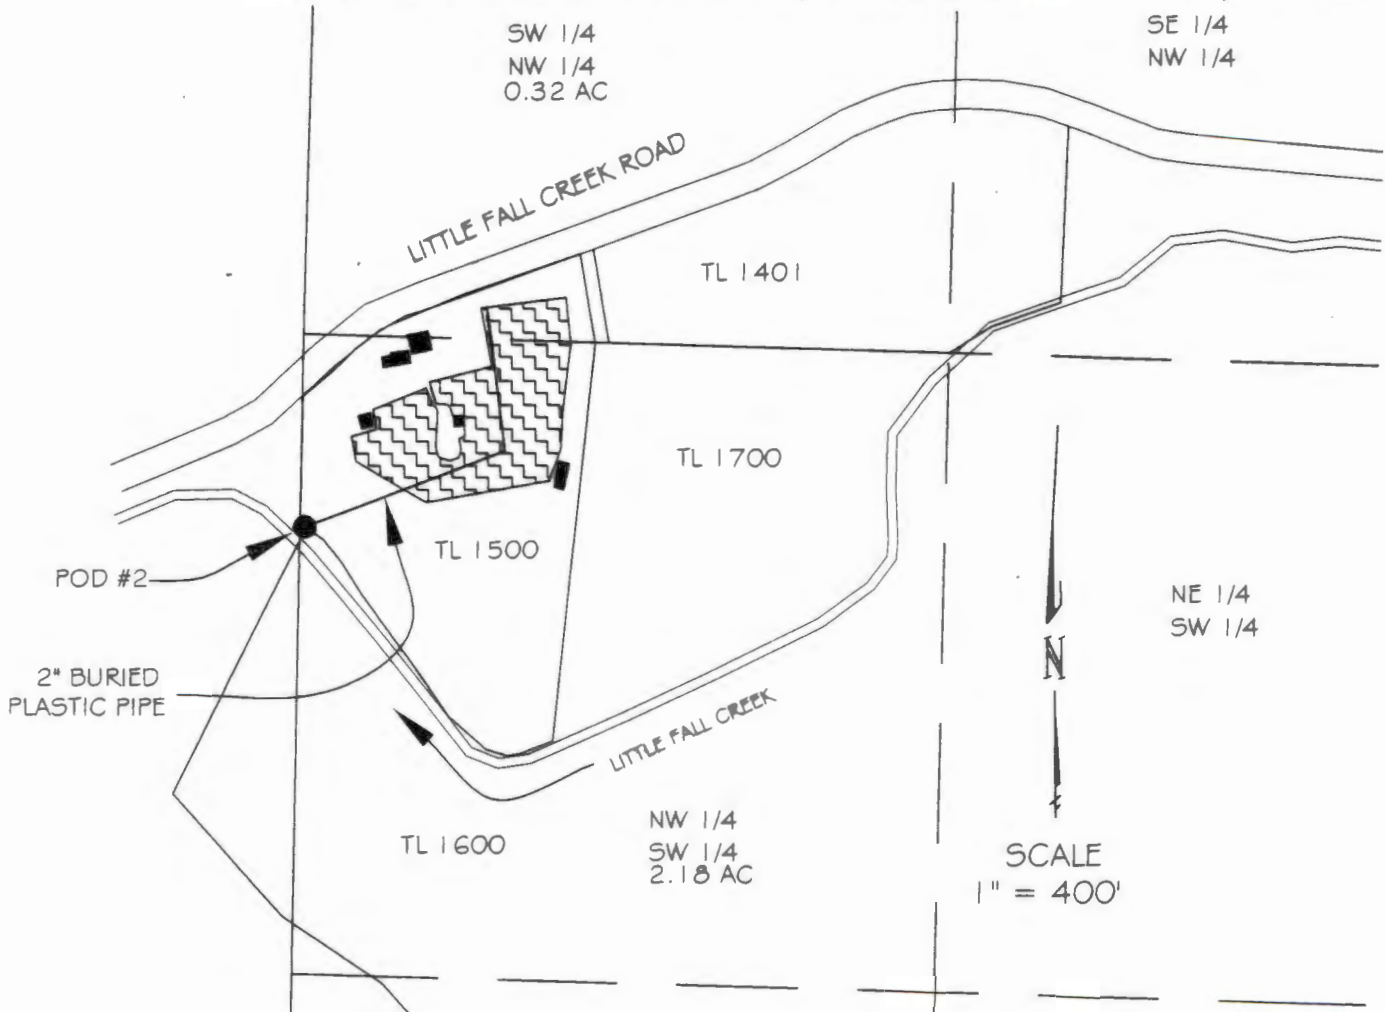

APPLICATION T-12195 SPECIAL ORDER VOL. 98, PG 776

FINAL PROOF SURVEY

FOR

LYNN & RHONDA MOORE
39326 LITTLE FALL CREEK ROAD
FALL CREEK, OR. 97438

BY

H. TIMOTHY FASSBENDER, PLS, CWRE
2896 SARAH LANE
EUGENE, OR. 97408

WELL LOCATION:

3046 FEET SOUTH & 814 FEET
 EAST FROM THE NW CORNER
 OF SECTION 34

NOTE:

MAP PROJECTION BASED UPON OREGON STATE PLANE
 COORDINATE SYSTEM NAD 83/91

NOTE:

THE PREPARATION OF THE MAP WAS
 FOR THE PURPOSE OF IDENTIFYING THE
 LOCATION OF THE WATER RIGHT ONLY.
 IT IS NOT INTENDED TO PROVIDE
 LOCATION NOR DIMENSION OF PROPERTY
 OWNERSHIP LINES.

RECEIVED BY OWRD

AUGUST 21, 2016

OCT 06 2016

SALEM, OR

