


**CLAIM OF BENEFICIAL USE: POINT OF DIVERSION MAP
TRANSFER T-6319 (PERMIT S-4980)
SECTIONS 15 & 22
TOWNSHIP 5S, R2E, W.M. CLACKAMAS COUNTY OREGON**

IN THE NAME OF
CITY OF MOLALLA, OREGON
NOVEMBER 4, 2020

\\dye2\dye-part\Aaprojects\198 Molalla\198.23 Trout Creek Water Transfer\DWG\198.23 COBU Map T-6319.dwg 1/28/2021 3:52:47 PM

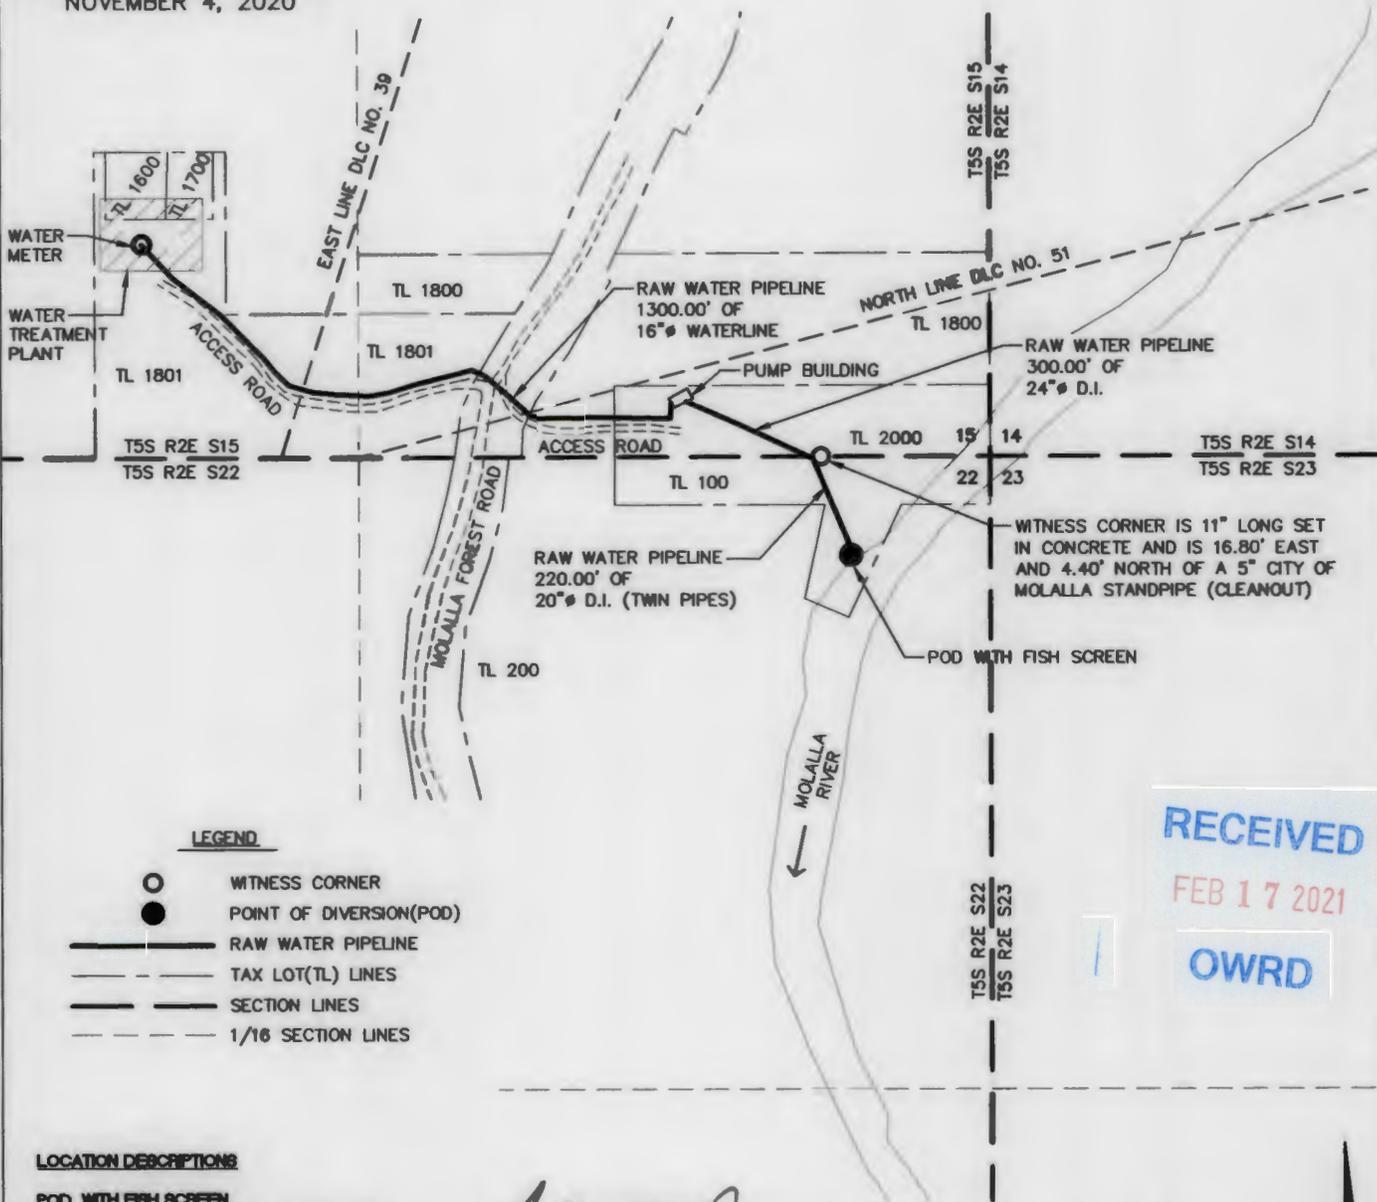

LEGEND

- WITNESS CORNER
- POINT OF DIVERSION(POD)
- RAW WATER PIPELINE
- TAX LOT(TL) LINES
- SECTION LINES
- 1/16 SECTION LINES

LOCATION DESCRIPTIONS


POD WITH FISH SCREEN
SOUTH 54° 51' 45" WEST A DISTANCE OF 356.2' FROM THE NORTHEAST CORNER OF SECTION 22, TOWNSHIP 5 SOUTH, RANGE 2 EAST (W.M.)

WATER METER
NORTH 75° 50' 53" WEST, A DISTANCE OF 1827.3' FROM THE NORTHEAST CORNER OF SECTION 22, TOWNSHIP 5 SOUTH, RANGE 2 EAST (W.M.)

WITNESS CORNER
354.13' WEST FROM THE NORTHEAST CORNER OF SECTION 22, TOWNSHIP 5 SOUTH, RANGE 2 EAST (W.M.)



EXPIRATION DATE: 12-31-21

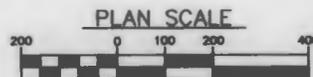

DISCLAIMER: THIS MAP IS FOR THE PURPOSE OF IDENTIFYING THE LOCATION OF THE WATER RIGHT ONLY AND IS NOT INTENDED TO PROVIDE LEGAL DIMENSIONS OR LOCATIONS OF PROPERTY LINES.

RECEIVED
FEB 17 2021
OWRD

<p>THE DYER PARTNERSHIP ENGINEERS & PLANNERS, INC.</p>	<p align="center">CITY OF MOLALLA TROUT CREEK WATER RIGHTS TRANSFER</p>	<p align="center">FIGURE NO. 1</p>
<p>DATE: NOV 2020 PROJECT NO.: 198.43</p>		