


**T1S R21E, WM,  
GILLIAM COUNTY, OR**




- Well & Meter
- ▨ POU (IS)
- Section
- ⋯ Quarter Quarter
- Tax Lot

Well (GILL 277) Location:  
4480' S, 2322' E of NW Cor Sec 3

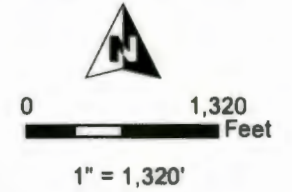

RENEWAL DATE 12/31/2019

RECEIVED  
BY  
OWR

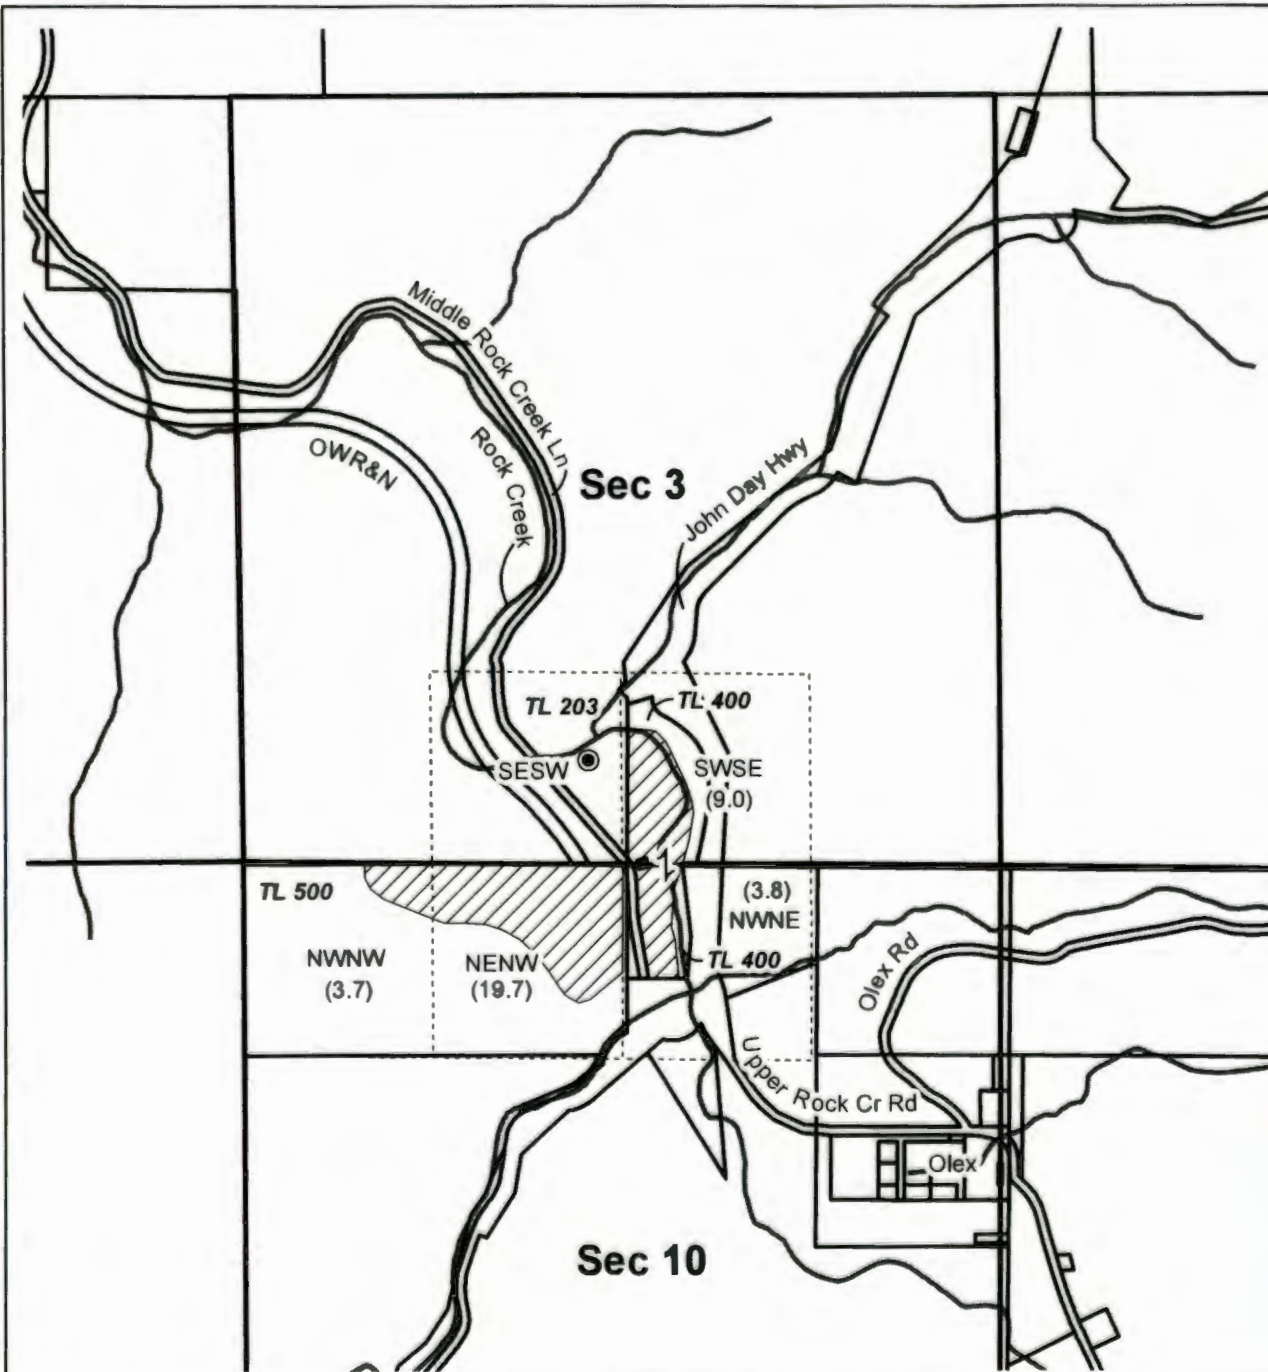

**CLAIM OF BENEFICIAL USE MAP  
WILDE RANCH**

Date: 11/9/2018

Ap G-18363

Permit G-17891

Project #18058

This map is not intended  
to provide legal dimensions  
or locations of property  
ownership lines.

**WATER RIGHT SERVICES, LLC**  
PO BOX 1830, BEND, OR 97709  
[WWW.OREGONWATER.US](http://WWW.OREGONWATER.US) CCB # 197121  
johnshort@usa.com 541-389-2837

400  
18.51 AC

PARTITION

17

PLAT

HWY

1. S77°11'57"W 83.25'
2. N12°48'03"W 80.85'
3. S77°11'57"W 83.25'
4. S12°48'03"W 80.85'

401  
0.09 AC

PARCEL 2

1/4 COR

18

STATE

792  
2008-04

CR

LN

792

792

510' +/-

244 +/-

60'

K