


TO CHANGE PLACE OF USE AND POINT OF APPROPRIATION
FOR TRANSFER APPLICATION T-12347

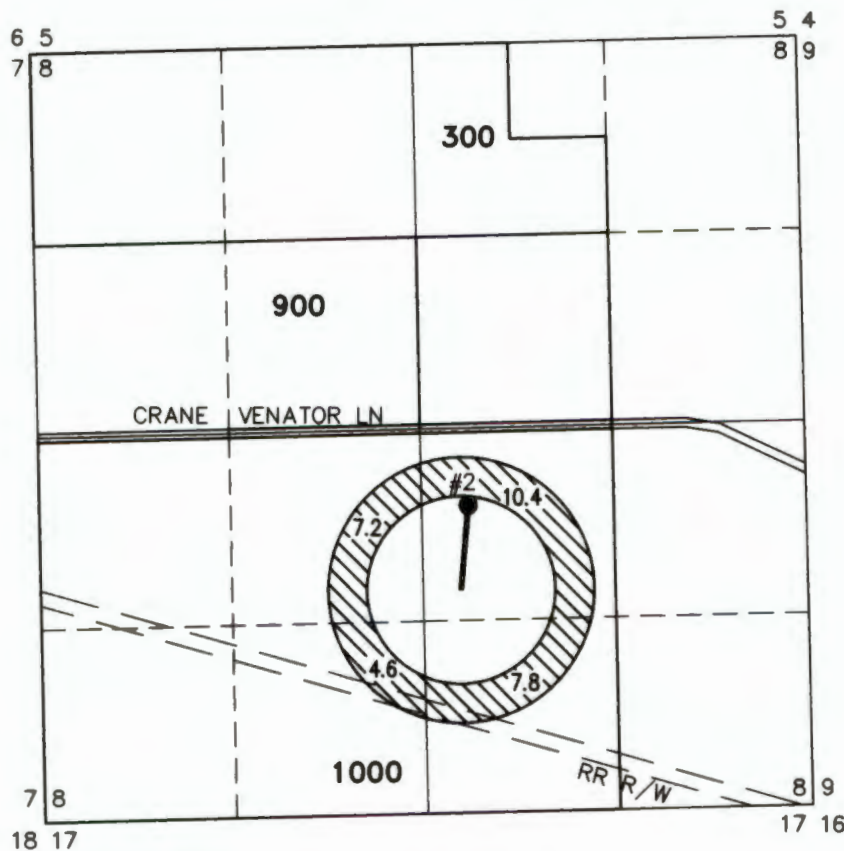

LOCATED IN THE NW 1/4 SE 1/4 SECTION 8, T25S
R34E, W.1M. AND 538 FEET SOUTH AND 2950 FEET
EAST FROM THE W 1/4 CORNER OF SECTION 8. FLOW
METER LOCATED 8 FEET WEST OF WELL.



30.0 ACRES WATER RIGHTS FROM
CERTIFICATE 26688 (PERMIT G-548),
TRANSFERRED AS SHOWN.



RENEWAL DATE: 12/31/2020

SUSAN SAUCY
P.O. BOX 706
CRANE, OR 97732

ALL POINTS ENGINEERING AND SURVEYING, INC.
P.O. BOX 767 TERREBONNE, OR 97760
(541) 548-5833 www.APEandS.com