

FINAL PROOF MAP


TO CHANGE PLACE OF USE AND POINT OF APPROPRIATION FOR TRANSFER APPLICATION T-12347

S 1/2 OF SECTION 8,
TOWNSHIP 25 SOUTH, RANGE 34 EAST, W.M.
TAX LOT: 1000

RECEIVED

AUG 29 2019

OWRD

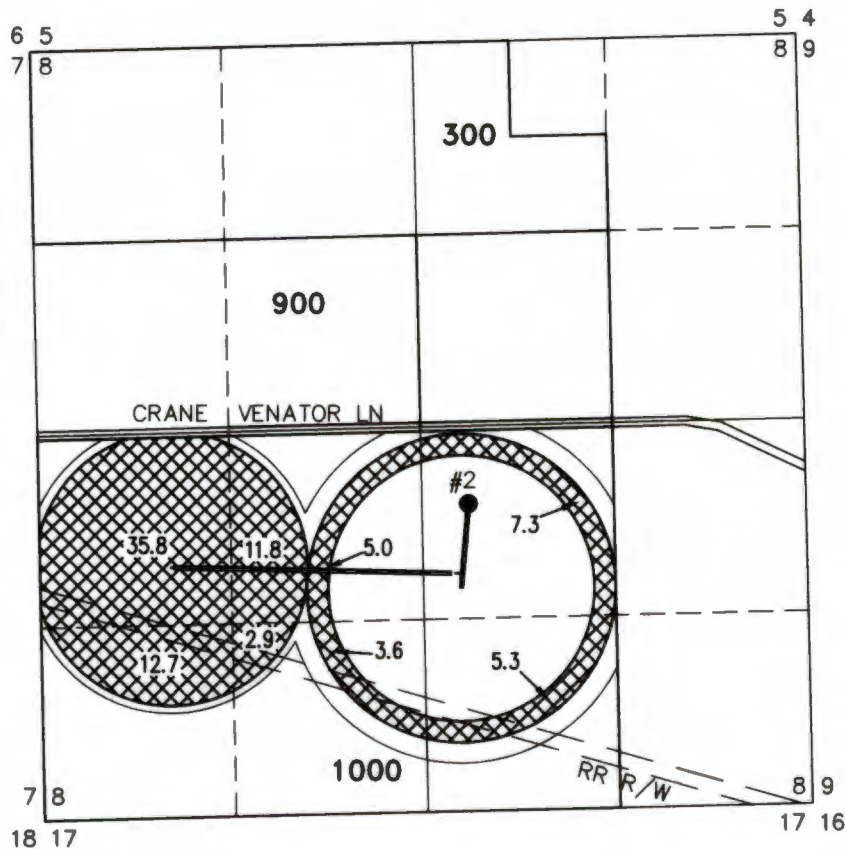


WELL 2 (HARN 50319)

LOCATED IN THE NW 1/4 SE 1/4 SECTION 8, T25S
R34E, W.M. AND 538 FEET SOUTH AND 2950 FEET
EAST FROM THE W 1/4 CORNER OF SECTION 8. FLOW
METER LOCATED 8 FEET WEST OF WELL.



84.4 ACRES WATER RIGHTS FROM
CERTIFICATE 47805 (PERMIT G-5469),
TRANSFERRED AS SHOWN.

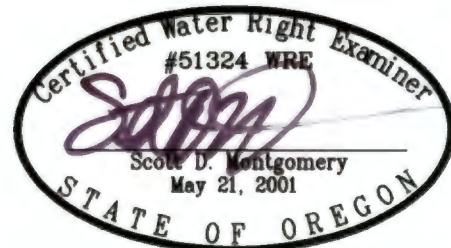

THIS MAP IS FOR THE PURPOSE OF LOCATING A WATER
RIGHT ONLY AND HAS NO INTENT TO PROVIDE LEGAL
DIMENSIONS OR THE LOCATION OF PROPERTY LINES

RENEWAL DATE: 12/31/2020

PREPARED FOR:

SUSAN SAUCY
P.O. BOX 706
CRANE, OR 97732

PREPARED BY:



ALL POINTS ENGINEERING AND SURVEYING, INC.
P.O. BOX 767 TERREBONNE, OR 97760
(541) 548-5833 www.APEandS.com