


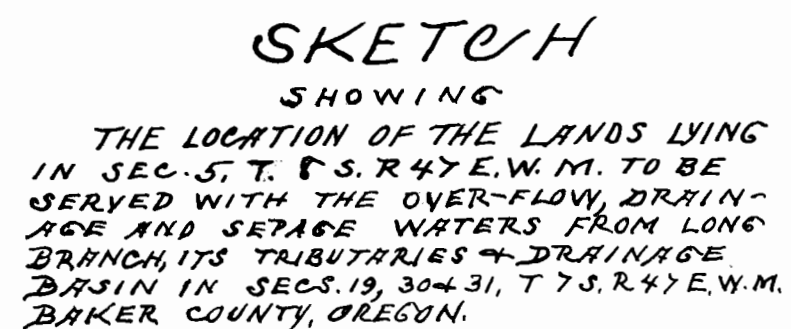

SCALE, ONE INCH = 1320 FT.

SURVEY MADE, JULY 13+14, 1928.

Ira L Hoffman
County Surveyor.

CERTIFICATE.

I, IRA L. HOFFMAN OF BAKE, OREGON,
DO HEREBY CERTIFY THAT THIS SKETCH
WAS MADE FROM NOTES TAKEN DURING
AN ACTUAL SURVEY MADE BY ME ON
JULY 13+14, 1928 AND THAT IT CORRECT
LY REPRESENTS THE DATA SHOWN
THEREON.

Ira L. Hoffman
County Surveyor.
REG. PROF. ENGINEER
#90 OREGON, NOV. 8, 1919.

T 7 S, R 47 E, W.M.

T 8 S, R 47 E, W. M.

