


Transfer Application - Weyerhaeuser

REVISED 10/24/2019

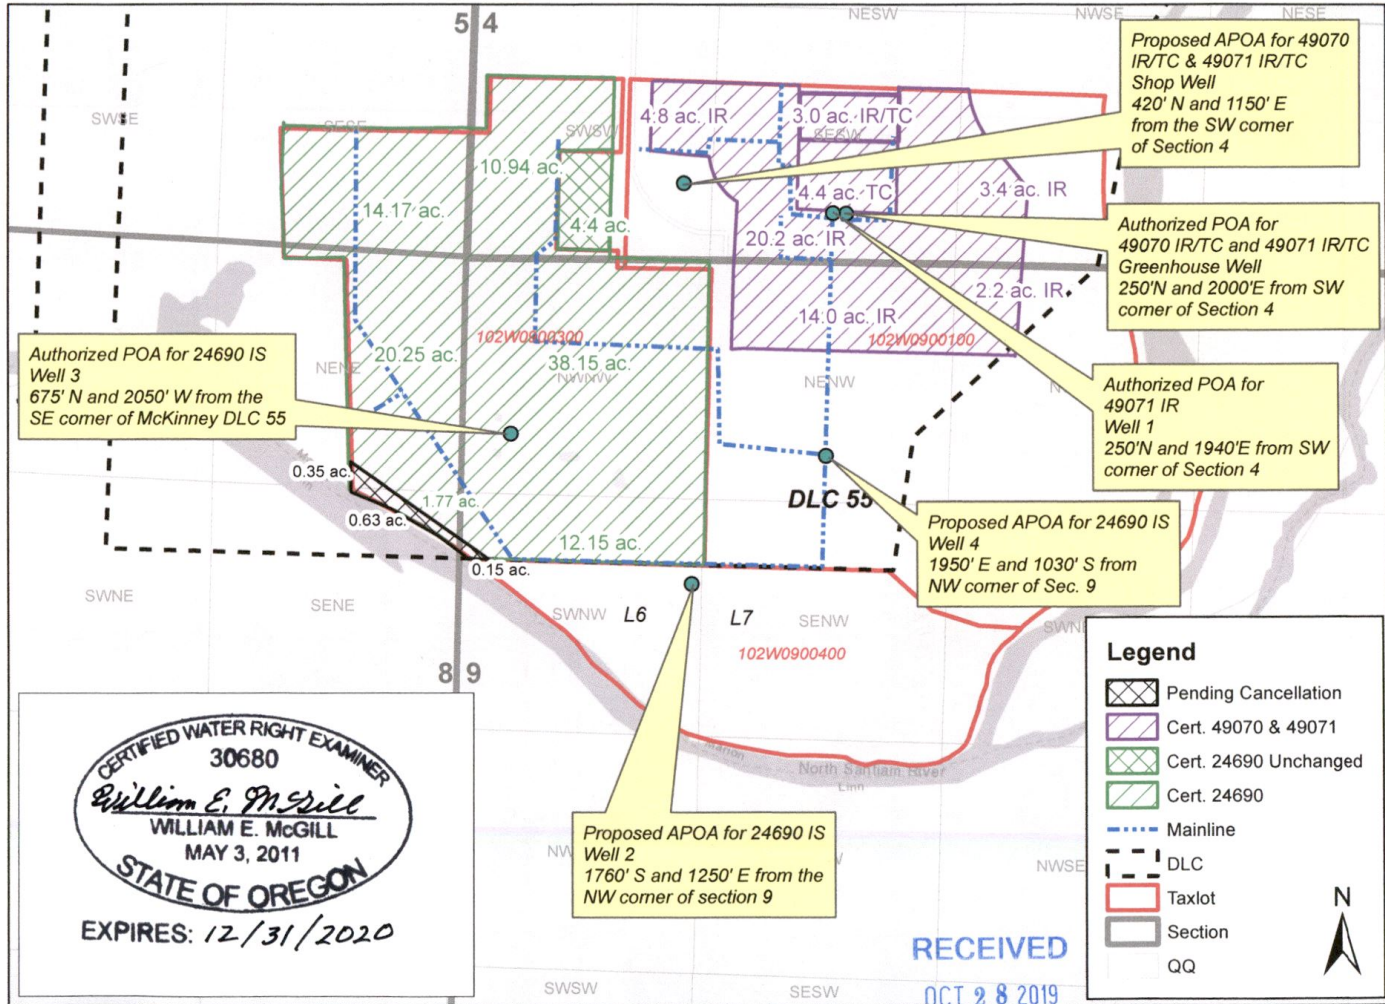

Proposed APOA for 49070 IR/TC & 49071 IR/TC Shop Well
420' N and 1150' E from the SW corner of Section 4

Authorized POA for 49070 IR/TC and 49071 IR/TC Greenhouse Well
250' N and 2000' E from SW corner of Section 4

Authorized POA for 49071 IR Well 1
250' N and 1940' E from SW corner of Section 4

Proposed APOA for 24690 IS Well 4
1950' E and 1030' S from NW corner of Sec. 9

Proposed APOA for 24690 IS Well 2
1760' S and 1250' E from the NW corner of section 9

Authorized POA for 24690 IS Well 3
675' N and 2050' W from the SE corner of McKinney DLC 55

CERTIFIED WATER RIGHT EXAMINER
30680
William E. McGill
WILLIAM E. MCGILL
MAY 3, 2011
STATE OF OREGON
EXPIRES: 12/31/2020

RECEIVED
OCT 28 2019