


RECEIVED

OCT 07 2019

OWRD

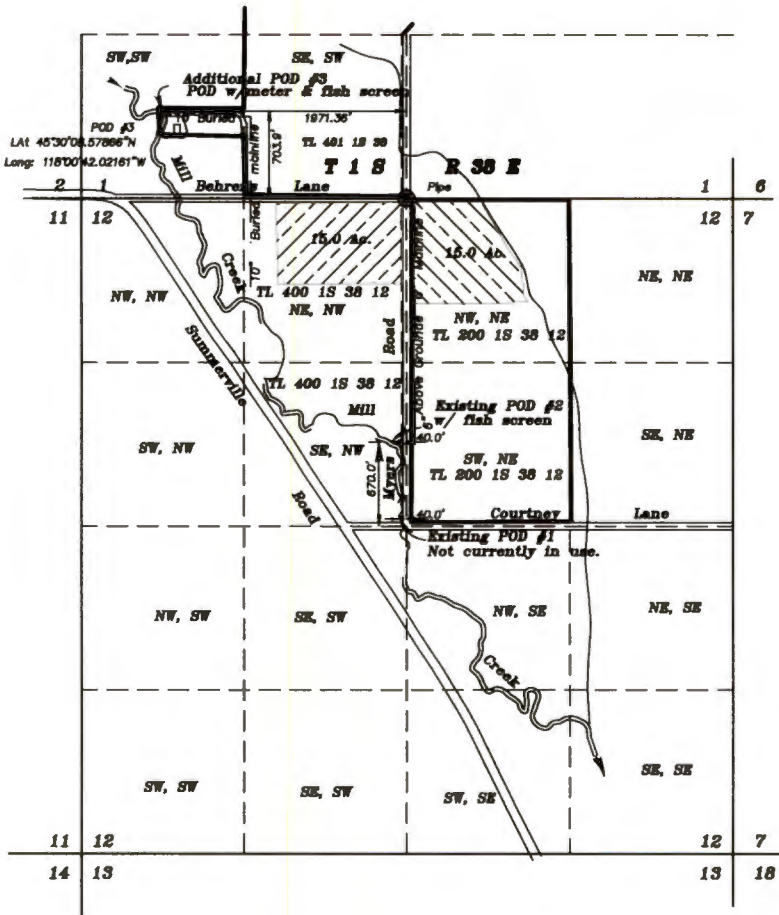

SCALE: 1"=1320'

POINTS OF DIVERSION

Authorized: POD #1
N 60' and 40' W of C 1/4 of Sec.
12, T1S 38E, WM.

Authorized: POD #2
N 670' and 40' W of C 1/4 of Sec.
12, T1S 38E, WM.

Existing Additional POD #3
N 703.9' and 1971.36' W of N 1/4
corner of Sect 12, T1S 38E, WM


Lat: 45°30'08.57866"N
Long: 118°00'42.02161"W



Lands currently irrigated under
T-8025 from POD's 1, 2, & additional
#3. Old certificate 46938 .



Lands currently irrigated under
T-8025 from POD's 1, 2, & additional
#3. Old certificate 46939 .

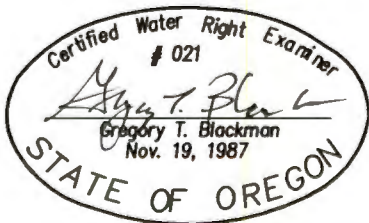

CLAIM OF BENEFICIAL USE MAP
AUTHORIZED UNDER T-8025
FOR

RETA CRUSON AND Samuel Bussard
BY

GREG BLACKMAN WATER RIGHTS
126 RIDGE DRIVE

LA GRANDE, OREGON 97850
May 30, 2019

APPLICATION NO. _____

PERMIT NUMBER T-8025

NOTE: The preparation of this map was for the purpose of identifying the location of the proposed water right and has no intent to provide dimensions or location of property ownership lines. Location information shown hereon was furnished by the applicant.