


CLAIM OF BENEFICIAL USE

FOR: DALE WAGONER
TRANSFER No. T-12624

T.21 S., R.3 W., W.M.
SECTION 5
DLC #40
TAX LOT #1001
LANE COUNTY, OREGON

MAP# 21-03-05-10 ALL IN TL#1001

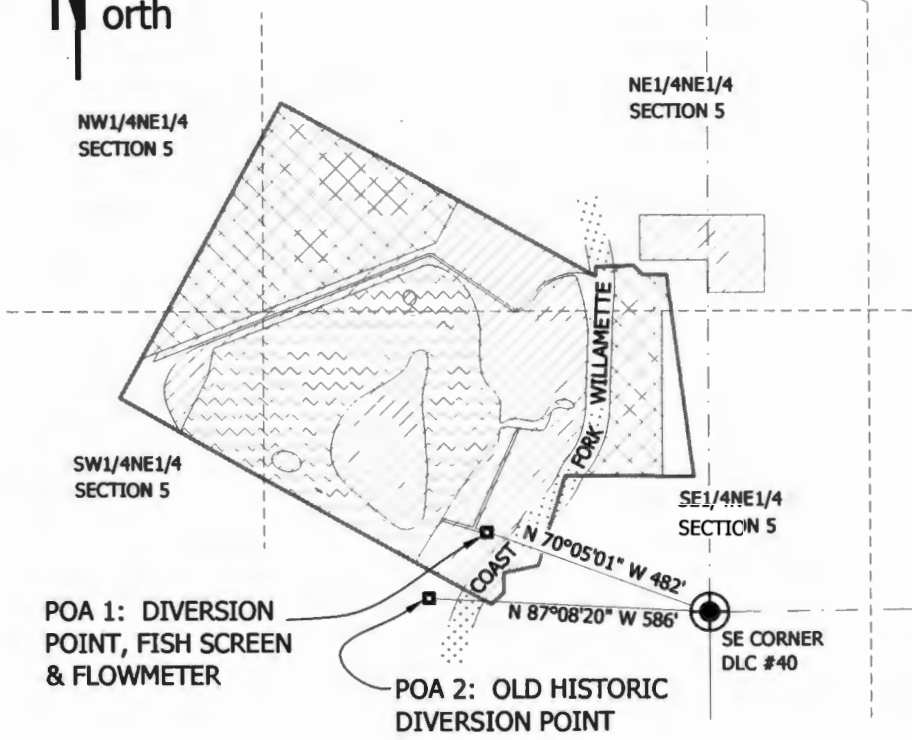

CERTIFICATE #26393 - APPLICATION #S-30162, PERMIT #S-23739 & POND UNDER APPLICATION R-30161 & PERMIT R-1774.

CERTIFICATE #35649 - APPLICATION #S-40815, PERMIT #S-30408.

CERTIFICATE #28889 - APPLICATION #S-32832, PERMIT #S-25911.

CERTIFICATE #26393
T.21 S., R.3 W. Sec. 5 - POND AREA (acres)

1/4 1/4	AREA	ISLAND	WATER
NENE	0.44	0.014	0.426
SWNE	0.79	0.0	0.79
SENE	4.43	1.54	2.89
TOTALS	5.66	1.554	4.106

CERTIFICATE #35649
T.21 S., R.3 W. Sec. 5 - IRRIGATION (acres)

1/4 1/4	AREA	Tax Lot	DLC
NENE	2.6	1001	40
SWNE	0.2	1001	40
SENE	1.0	1001	40
NWNE	0.7	1001	40
TOTALS	5.66		

CERTIFICATE #28889
T.21 S., R.3 W. Sec. 5 - IRRIGATION (acres)


1/4 1/4	AREA	Tax Lot	DLC
NENE	1.5	1001	40
SWNE	0.25	1001	40
SENE	2.25	1001	40
TOTALS	4.00		

LEGEND

- SECTION SUBDIVISION LINE
- D.L.C. LINE
- PROPERTY LINE
- WATER PIPELINE
- CERTIFICATE #35649 IRRIGATED ACRES
- CERTIFICATE #26393 IRRIGATED ACRES
- CERTIFICATE #28889 IRRIGATED ACRES



THIS MAP IS NOT INTENDED TO PROVIDE LEGAL DIMENSIONS OR LOCATION OF PROPERTY OWNERSHIP LINES.

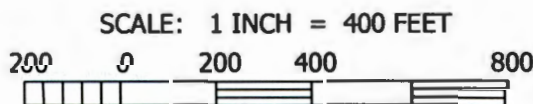

RENEWAL DATE: 12-31-2020
DONN ROWE
(541) 953-7778
90946 SUNDERMAN ROAD
SPRINGFIELD, OR. 97478