


T 33 S, R 30 E, WM

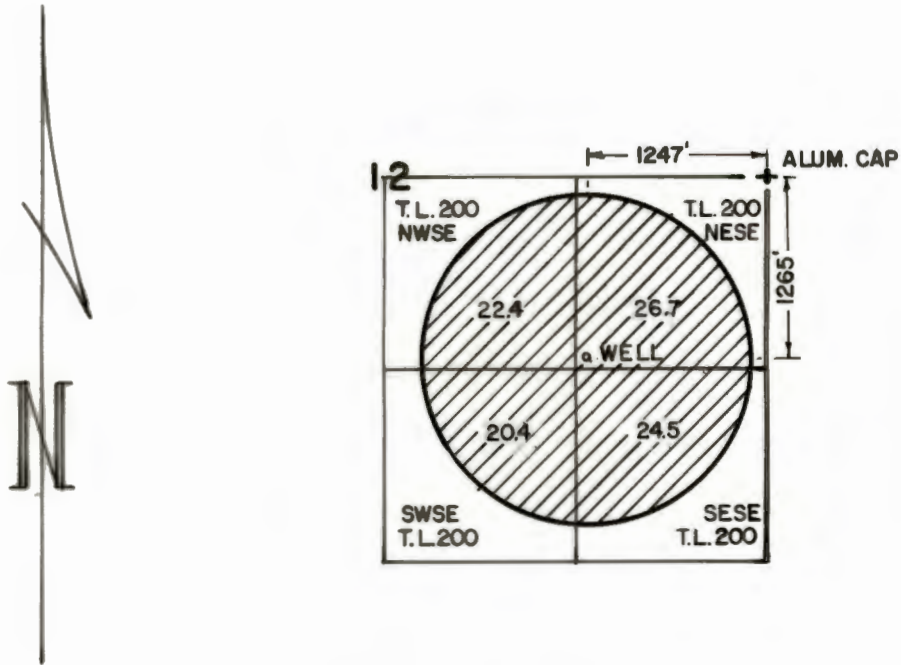


THE PURPOSE OF THIS MAP IS TO IDENTIFY THE LOCATION OF THE WATER RIGHT. IT IS NOT INTENDED TO PROVIDE INFORMATION RELATIVE TO THE LOCATION OF PROPERTY OWNERSHIP.

RECEIVED

DEC 20 2002

WATER RESOURCES DEPT.
SALEM, OREGON

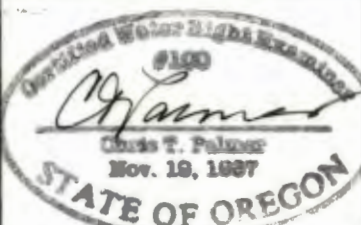 RENEW 1-1-2003	FINAL PROOF SURVEY		
	UNDER APPLICATION G-14536 PERMIT G-13356		IN THE NAME OF JOE MILLER
	Scale: 4" = 1 MILE	Date: DEC. 2002	Job: 2115
	Dsn:	 M.A. PALMER & SONS, INC. ENGINEERING & SURVEYING 711 Ponderosa Village • Box 61 Burns, Oregon 97720	Sht. No.
	Dm: CHRIS		of 1
Ckd:			