

CLAIM OF BENEFICIAL USE MAP

TO ADD A POINT OF APPROPRIATION AND PLACE OF USE
FOR APPLICATIONS G-16917 & T-10965



BO THORENFELDT

TOWNSHIP 23 SOUTH, RANGE 33 EAST, SECTION 29, W.M.
TAX LOT: 600

RECEIVED

MAY 10 2021

OWRD

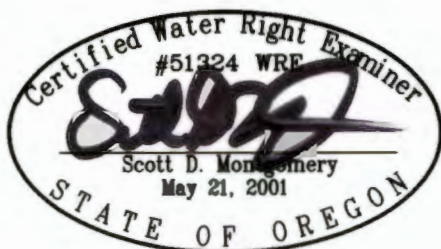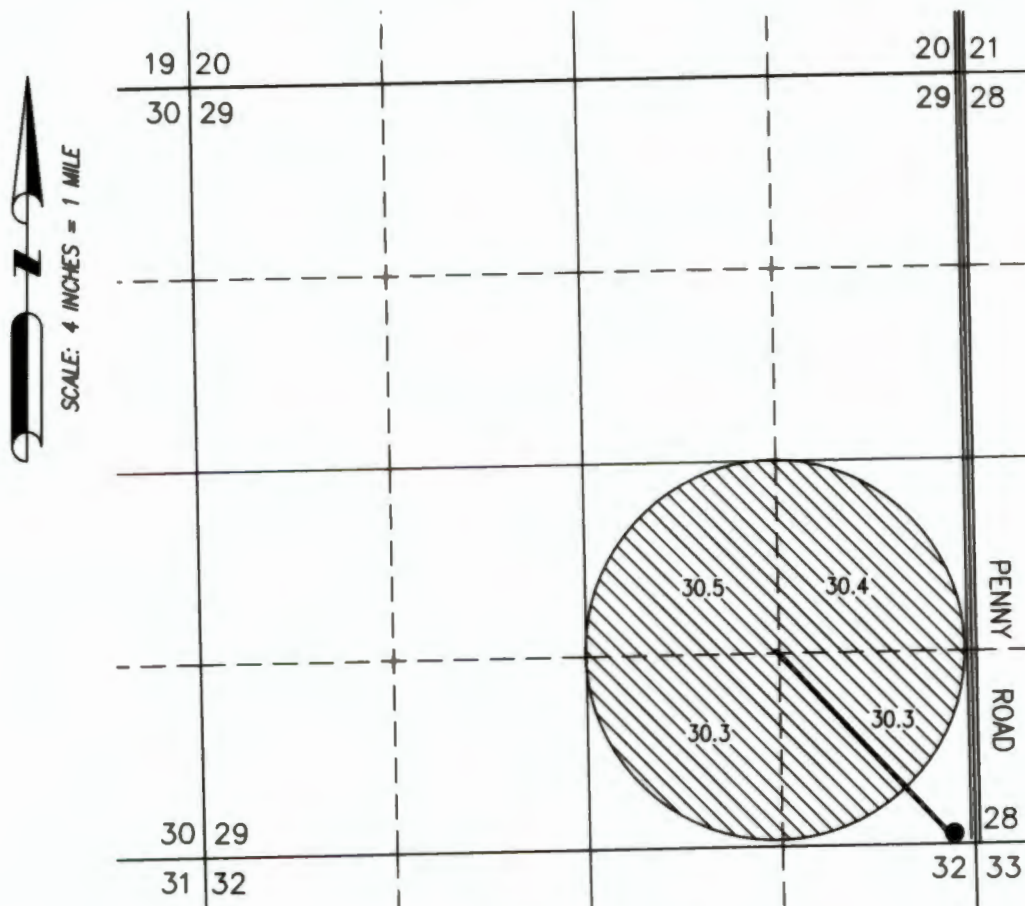

RENEWAL DATE: 12/31/2022

WELL (HARN 51473)

LOCATED IN THE SE 1/4 SE 1/4 SECTION 29, T23S R33E, W.M.
AND N 76°28'10" W 193' FROM ASSUMED SE CORNER SECTION 29.

TOTALIZING FLOW METER IS LOCATED 53 FEET WEST OF THE WELL
ON THE DELIVERY PIPE.



121.5 ACRES PRIMARY RIGHTS FROM AUTHORIZED
WELL (T-10965), AS SHOWN.

THIS MAP IS FOR THE PURPOSE OF LOCATING A WATER RIGHT ONLY AND HAS NO
INTENT TO PROVIDE LEGAL DIMENSIONS OR THE LOCATION OF PROPERTY LINES.

PREPARED FOR:

BO THORENFELDT
885 HILLSBOROUGH BLVD.
HILLSBOROUGH, CA 94010

PREPARED BY:



ALL POINTS ENGINEERING AND SURVEYING, INC.
P.O. BOX 767
(541) 548-5833
TERREBONNE, OR 97760
www.APEandS.com