

CLAIM OF BENEFICIAL USE MAP

TO ADD A POINT OF APPROPRIATION AND PLACE OF USE
FOR APPLICATIONS G-8816 & T-12529


BO THORENFELDT

TOWNSHIP 23 SOUTH, RANGE 33 EAST, SECTION 20, W.M.
TAX LOTS: 4000 & 4100

RECEIVED

MAY 20 2021

OWRD

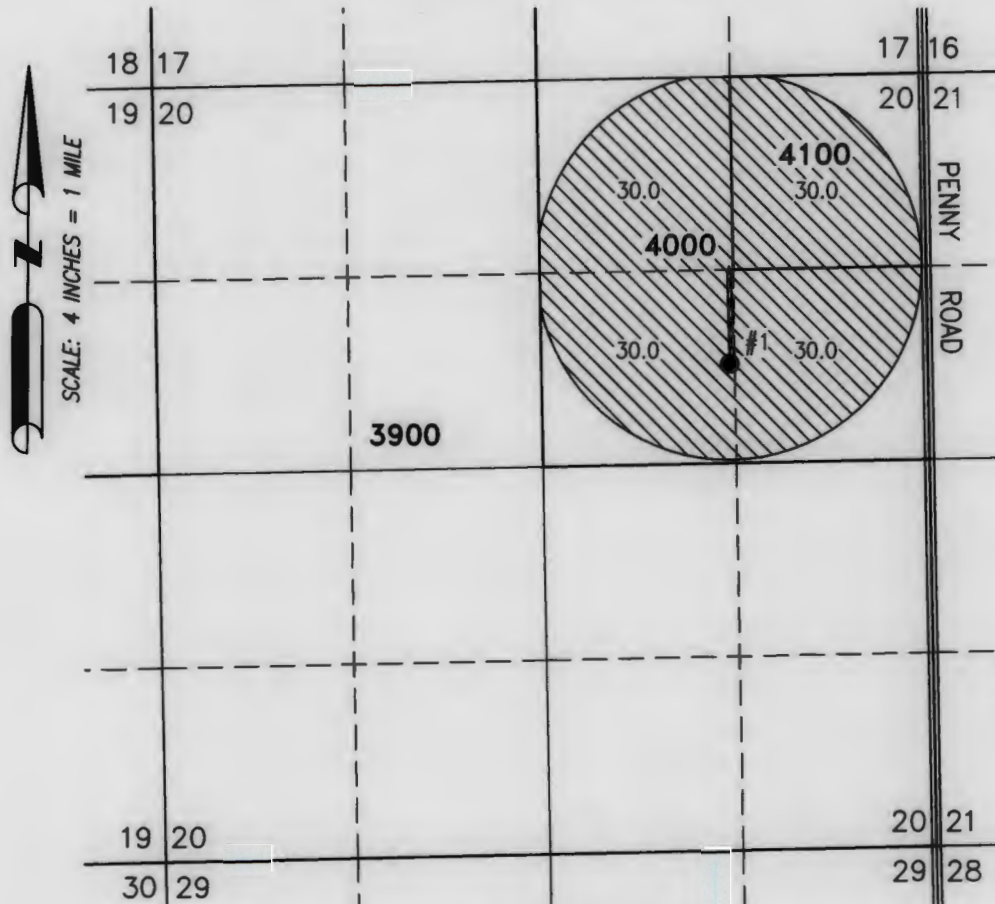


POA 1 (HARN 691)

LOCATED IN THE SW 1/4 NE 1/4 SECTION 20, T23S R33E, W.M.
AND 655' NORTH & 1340' WEST FROM ASSUMED E 1/4 CORNER
SECTION 20.

TOTALIZING FLOW METER IS LOCATED 11 FEET NE OF THE WELL ON
THE DELIVERY PIPE.



120.0 ACRES PRIMARY RIGHTS FROM AUTHORIZED
POA 1, AS SHOWN.

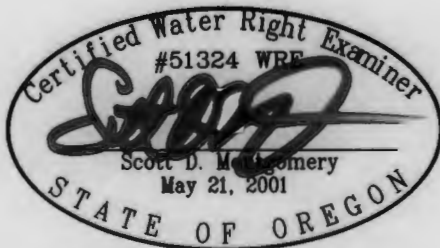

RENEWAL DATE: 12/31/2022

THIS MAP IS FOR THE PURPOSE OF LOCATING A WATER RIGHT ONLY AND HAS NO
INTENT TO PROVIDE LEGAL DIMENSIONS OR THE LOCATION OF PROPERTY LINES.

PREPARED FOR:

BO THORENFELDT
885 HILLSBOROUGH BLVD.
HILLSBOROUGH, CA 94010

PREPARED BY:



ALL POINTS ENGINEERING AND SURVEYING, INC.
P.O. BOX 767
(541) 548-5833
TERREBONNE, OR 97760
www.APEandS.com