


T. 39 S. R. 7 W.W.M.

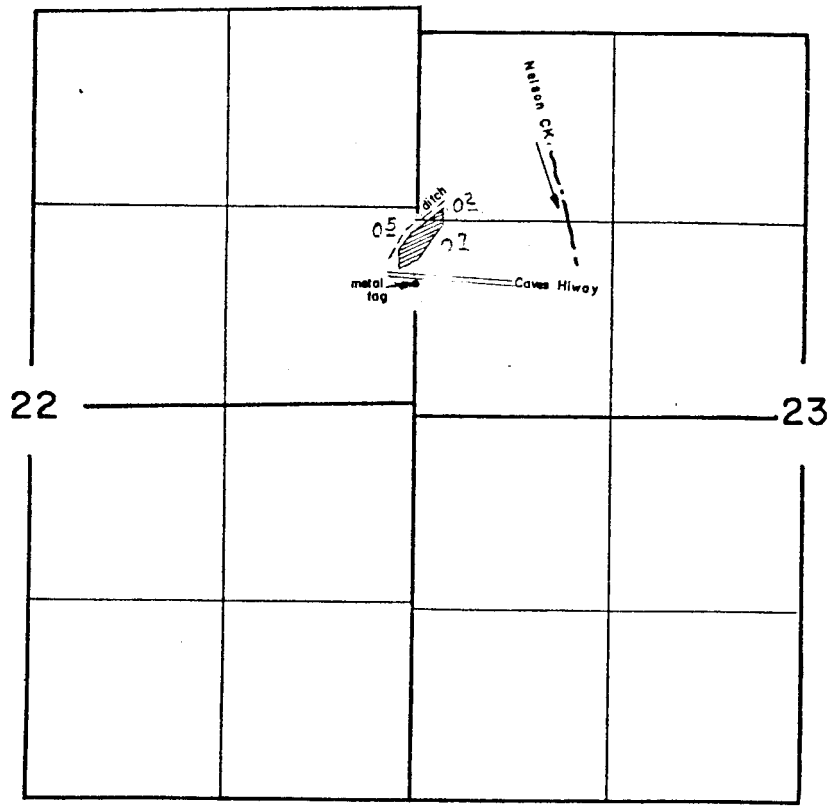

FINAL PROOF SURVEY
UNDER

Application No. 12964... Permit No. 9229
IN NAME OF

.....C. H. MORELAND.....

Surveyed NOV. 2, 1964, by R. B. Steimer.

NOV 10 1964