

FINAL PROOF MAP


TO ADD POINTS OF APPROPRIATION & PLACE OF
USE FOR APPLICATIONS G-17041 & G-17135
DON AND PAT WELLS

RECEIVED

OCT 18 2019

OWRD


TOWNSHIP 23 SOUTH, RANGE 33 EAST, SECTION 10, W.M.
TAX LOTS: 1400, 1500, & 1600

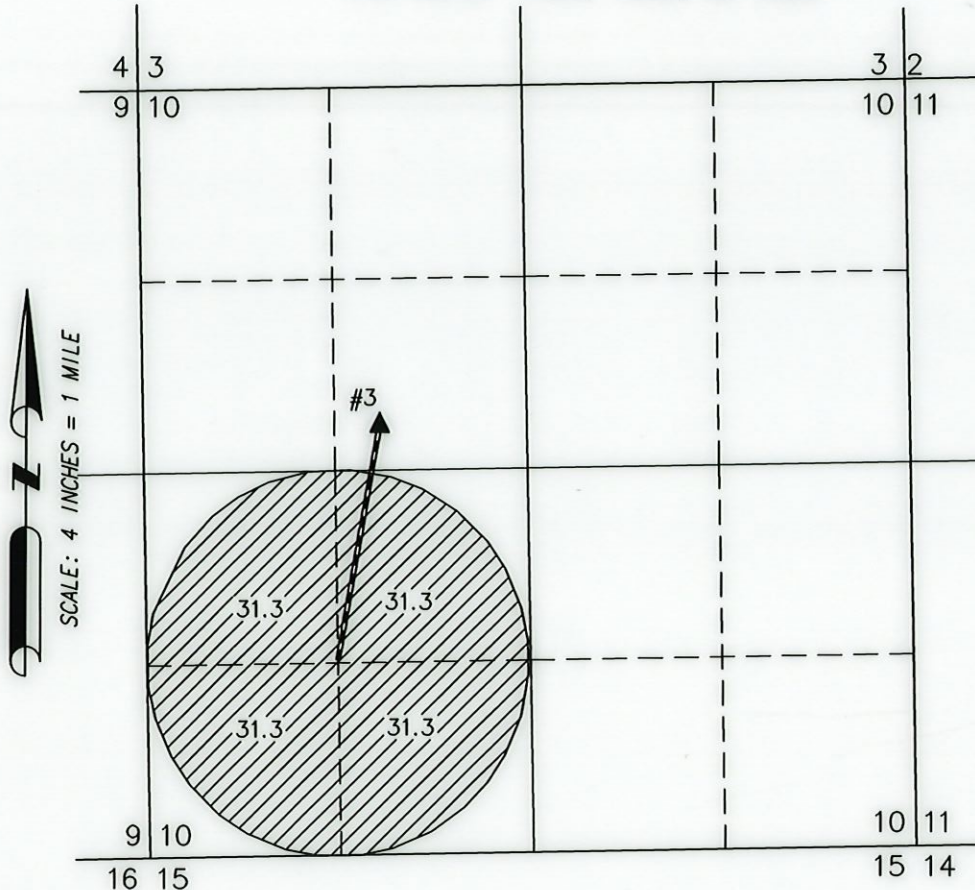

125.2 ACRES PRIMARY IRRIGATION
AUTHORIZED FROM POA #3 BY
PERMITS G-17849 & G-17850

● #3 (HARN 52746)

LOCATED IN THE SE 1/4 NW 1/4 SECTION 10, T23S
R33E, W.M. AND 2325 FEET SOUTH AND 1010 FEET
WEST FROM THE N 1/4 CORNER OF SAID SECTION.
FLOW METER IS 4' SOUTH FROM WELL.

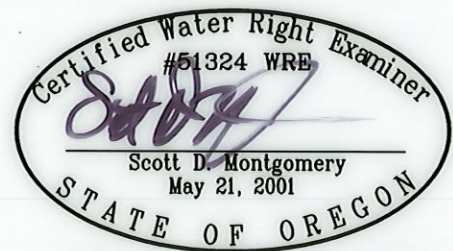

RENEWAL DATE: 12/31/2020

THIS MAP IS FOR THE PURPOSE OF LOCATING A WATER
RIGHT ONLY AND HAS NO INTENT TO PROVIDE LEGAL
DIMENSIONS OR THE LOCATION OF PROPERTY LINES.

PREPARED FOR:

DON & PAT WELLS
72023 CRANE-BUCHANAN RD
BURNS, OR 97720

PREPARED BY:



ALL POINTS ENGINEERING AND SURVEYING, INC.
P.O. BOX 767 TERREBONNE, OR 97760
(541) 548-5833 www.APEandS.com