



Twp. 39S R. 5 W

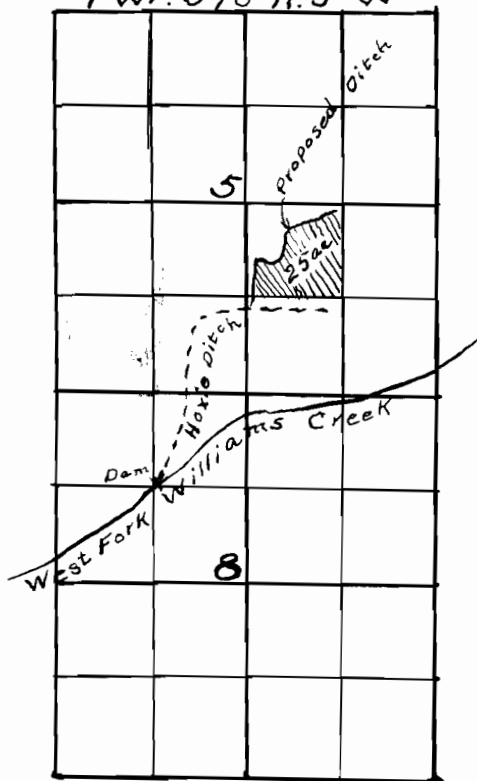

777.5
4967

TWP. 39 S R. 5 W

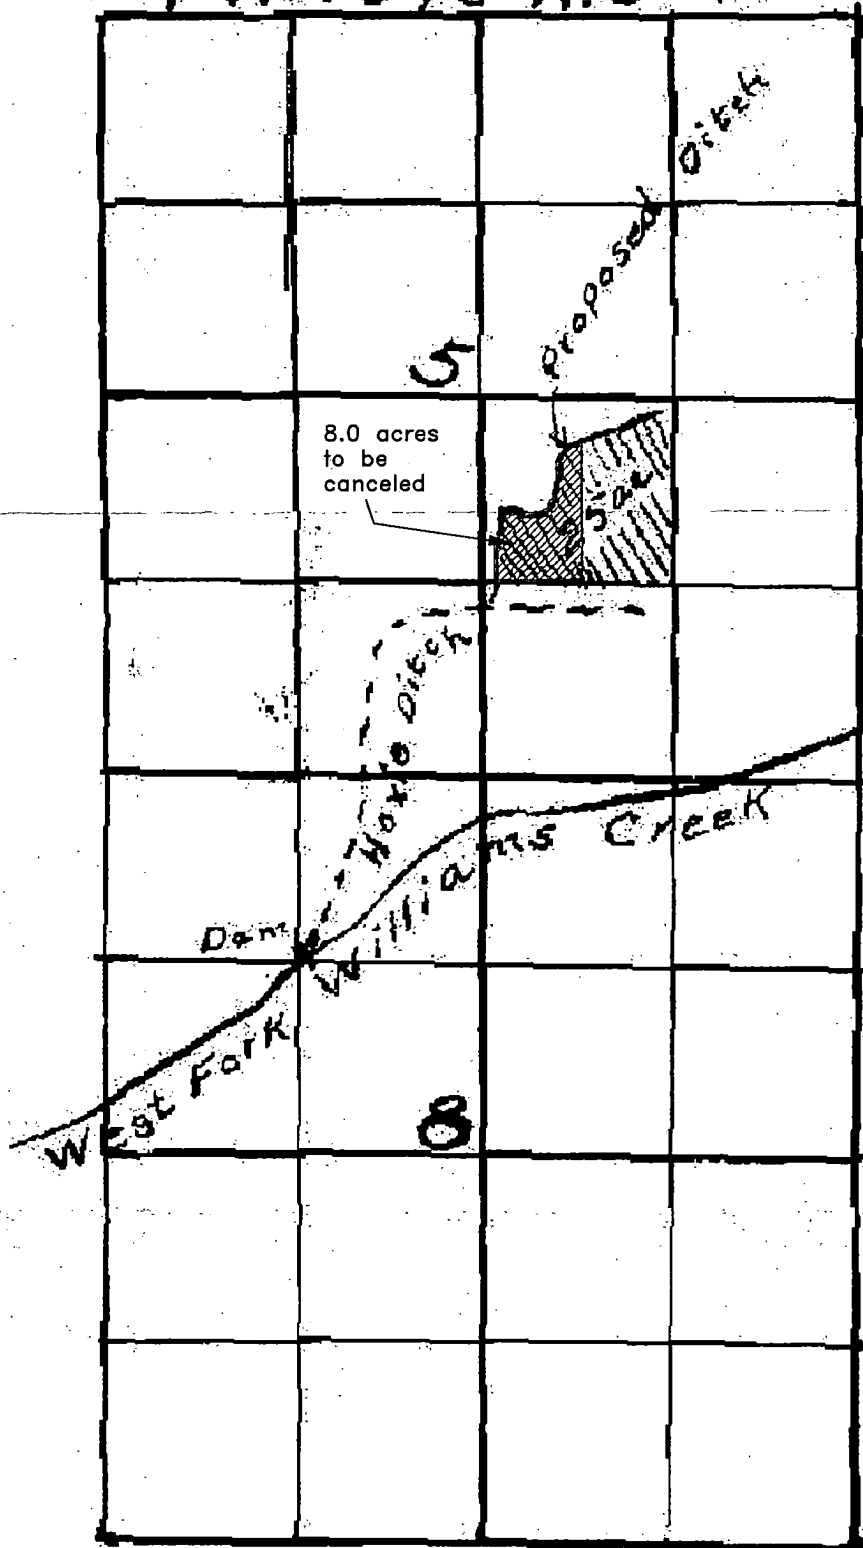

Map to go along with
cancellation affidavit for
8.0 acres under
Certificate 3465

777.5
4967