


# FINAL PROOF SURVEY

Gordon and Julie Larson

Transfer No. 12718

Township 14 South, Range 31 East, Sections 35 & 36 W.M.

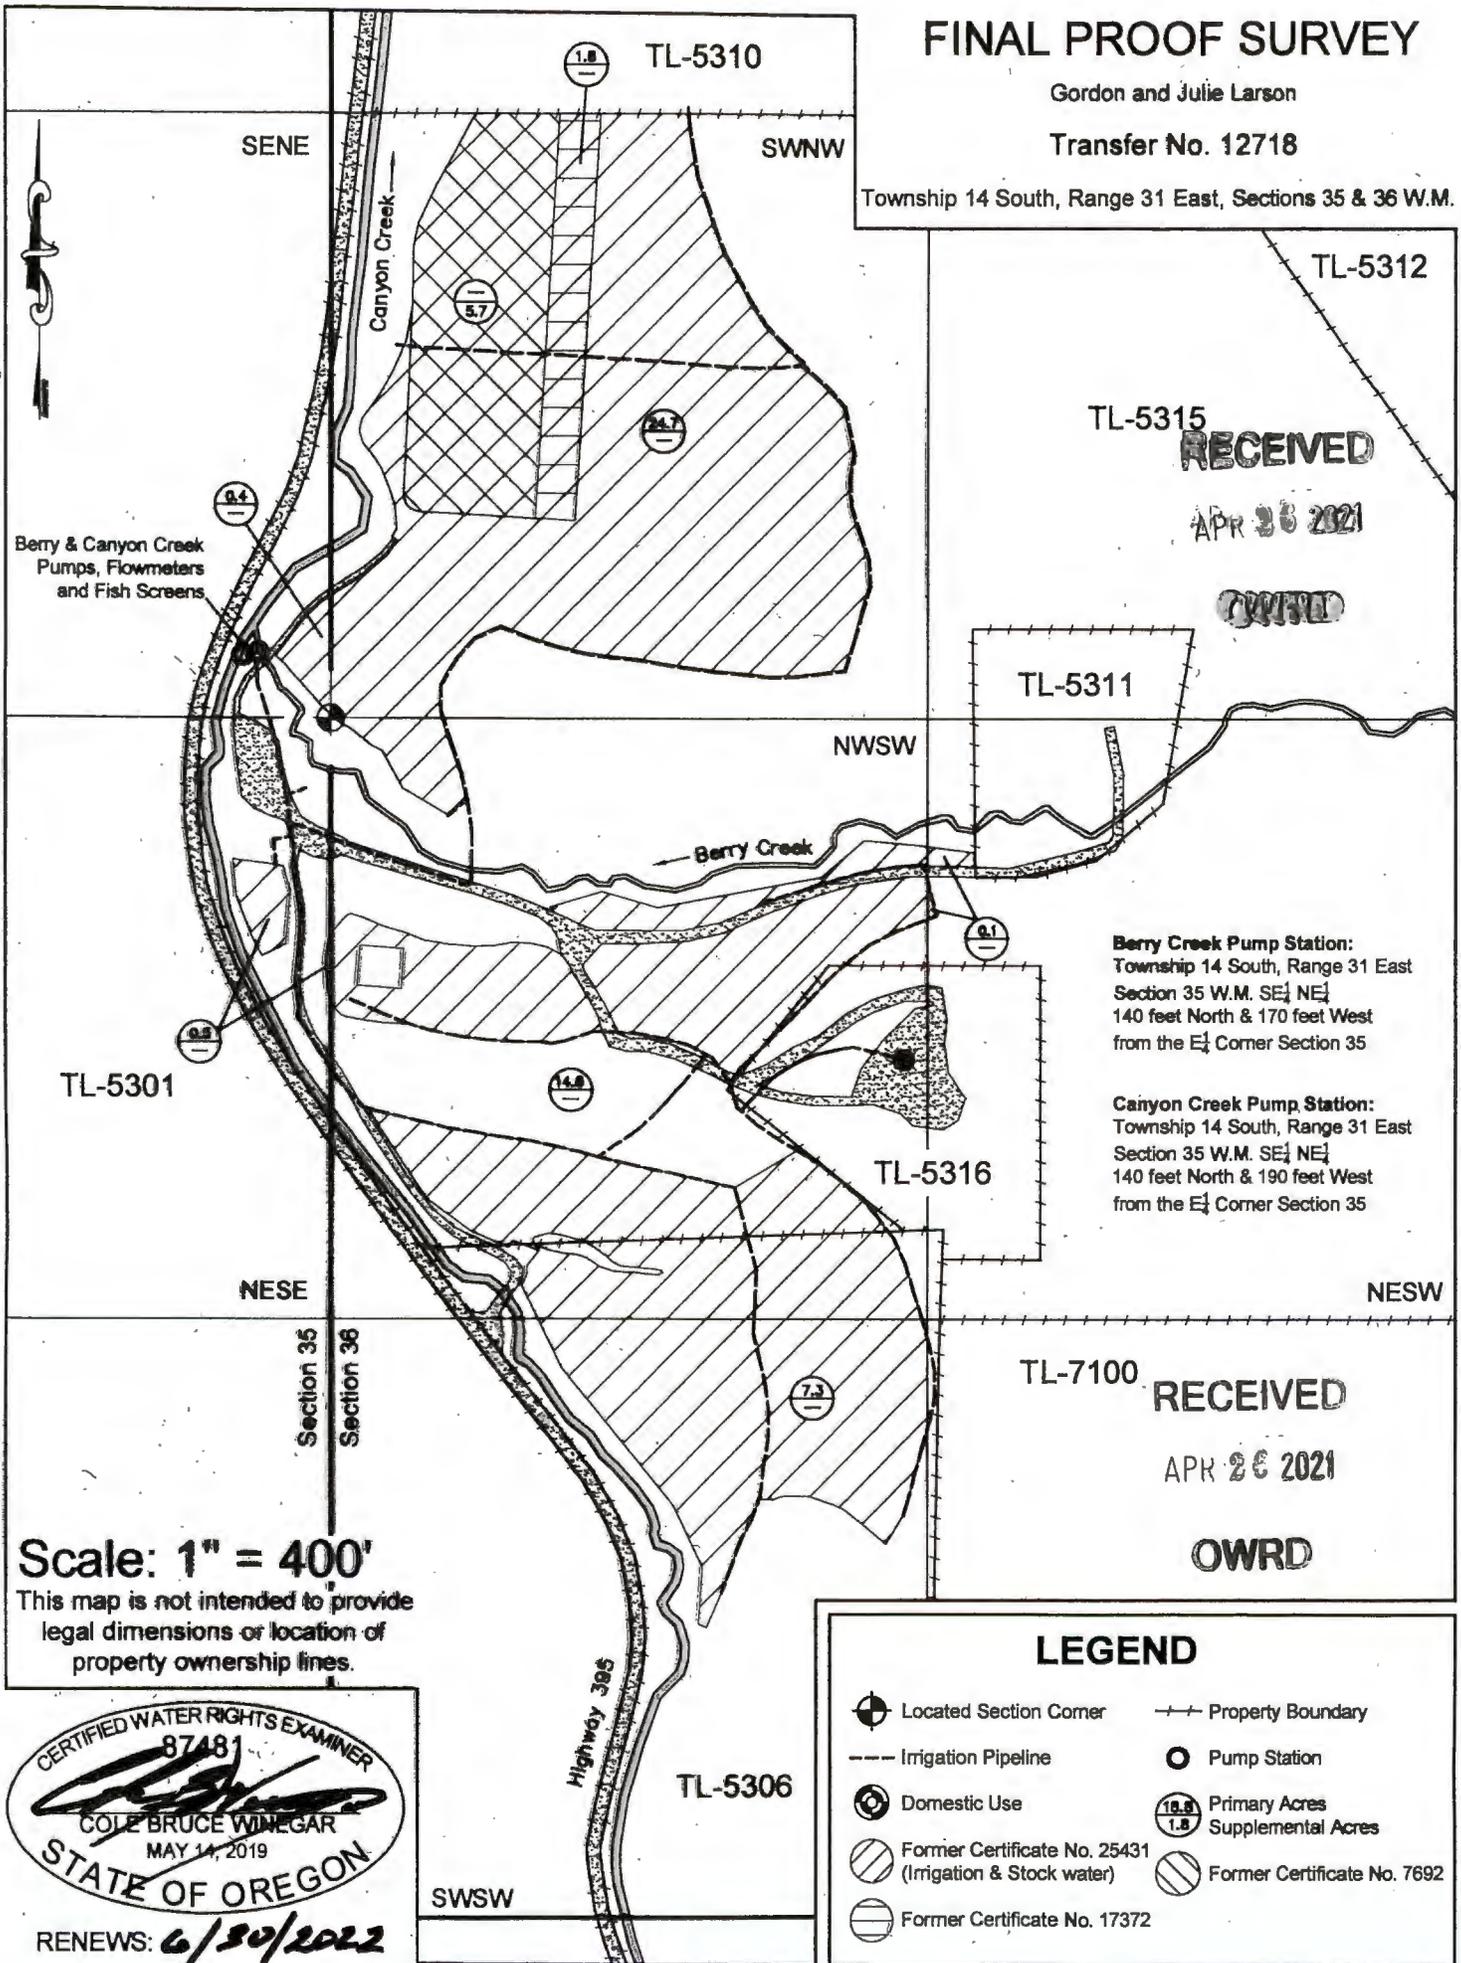

RECEIVED

APR 26 2021

OWRD

**Berry Creek Pump Station:**  
Township 14 South, Range 31 East  
Section 35 W.M. SE 1/4 NE 1/4  
140 feet North & 170 feet West  
from the E 1/4 Corner Section 35


**Canyon Creek Pump Station:**  
Township 14 South, Range 31 East  
Section 35 W.M. SE 1/4 NE 1/4  
140 feet North & 190 feet West  
from the E 1/4 Corner Section 35

RECEIVED

APR 26 2021

OWRD

**Scale: 1" = 400'**  
This map is not intended to provide  
legal dimensions or location of  
property ownership lines.

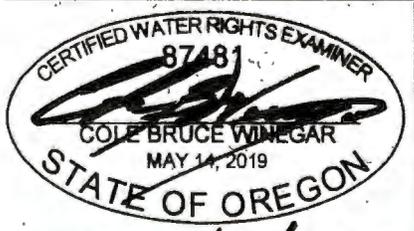

RENEWS: 6/30/2022

### LEGEND

|  |  |  |                             |
|--|--|--|-----------------------------|
|  | Located Section Corner                                     |  | Property Boundary           |
|  | Irrigation Pipeline  |  | Pump Station                |
|  | Domestic Use   |  | Primary Acres               |
|  | Former Certificate No. 25431<br>(Irrigation & Stock water) |  | Supplemental Acres          |
|  | Former Certificate No. 17372                               |  | Former Certificate No. 7692 |