


Section 35, T16S, R20E and Sections 2, 3, 4 & 9, T17S, R20E, W.M.,
 Crook County, Oregon
CLAIM OF BENEFICIAL USE MAP
 Transfer T-12989
 Crooked River East, LLC

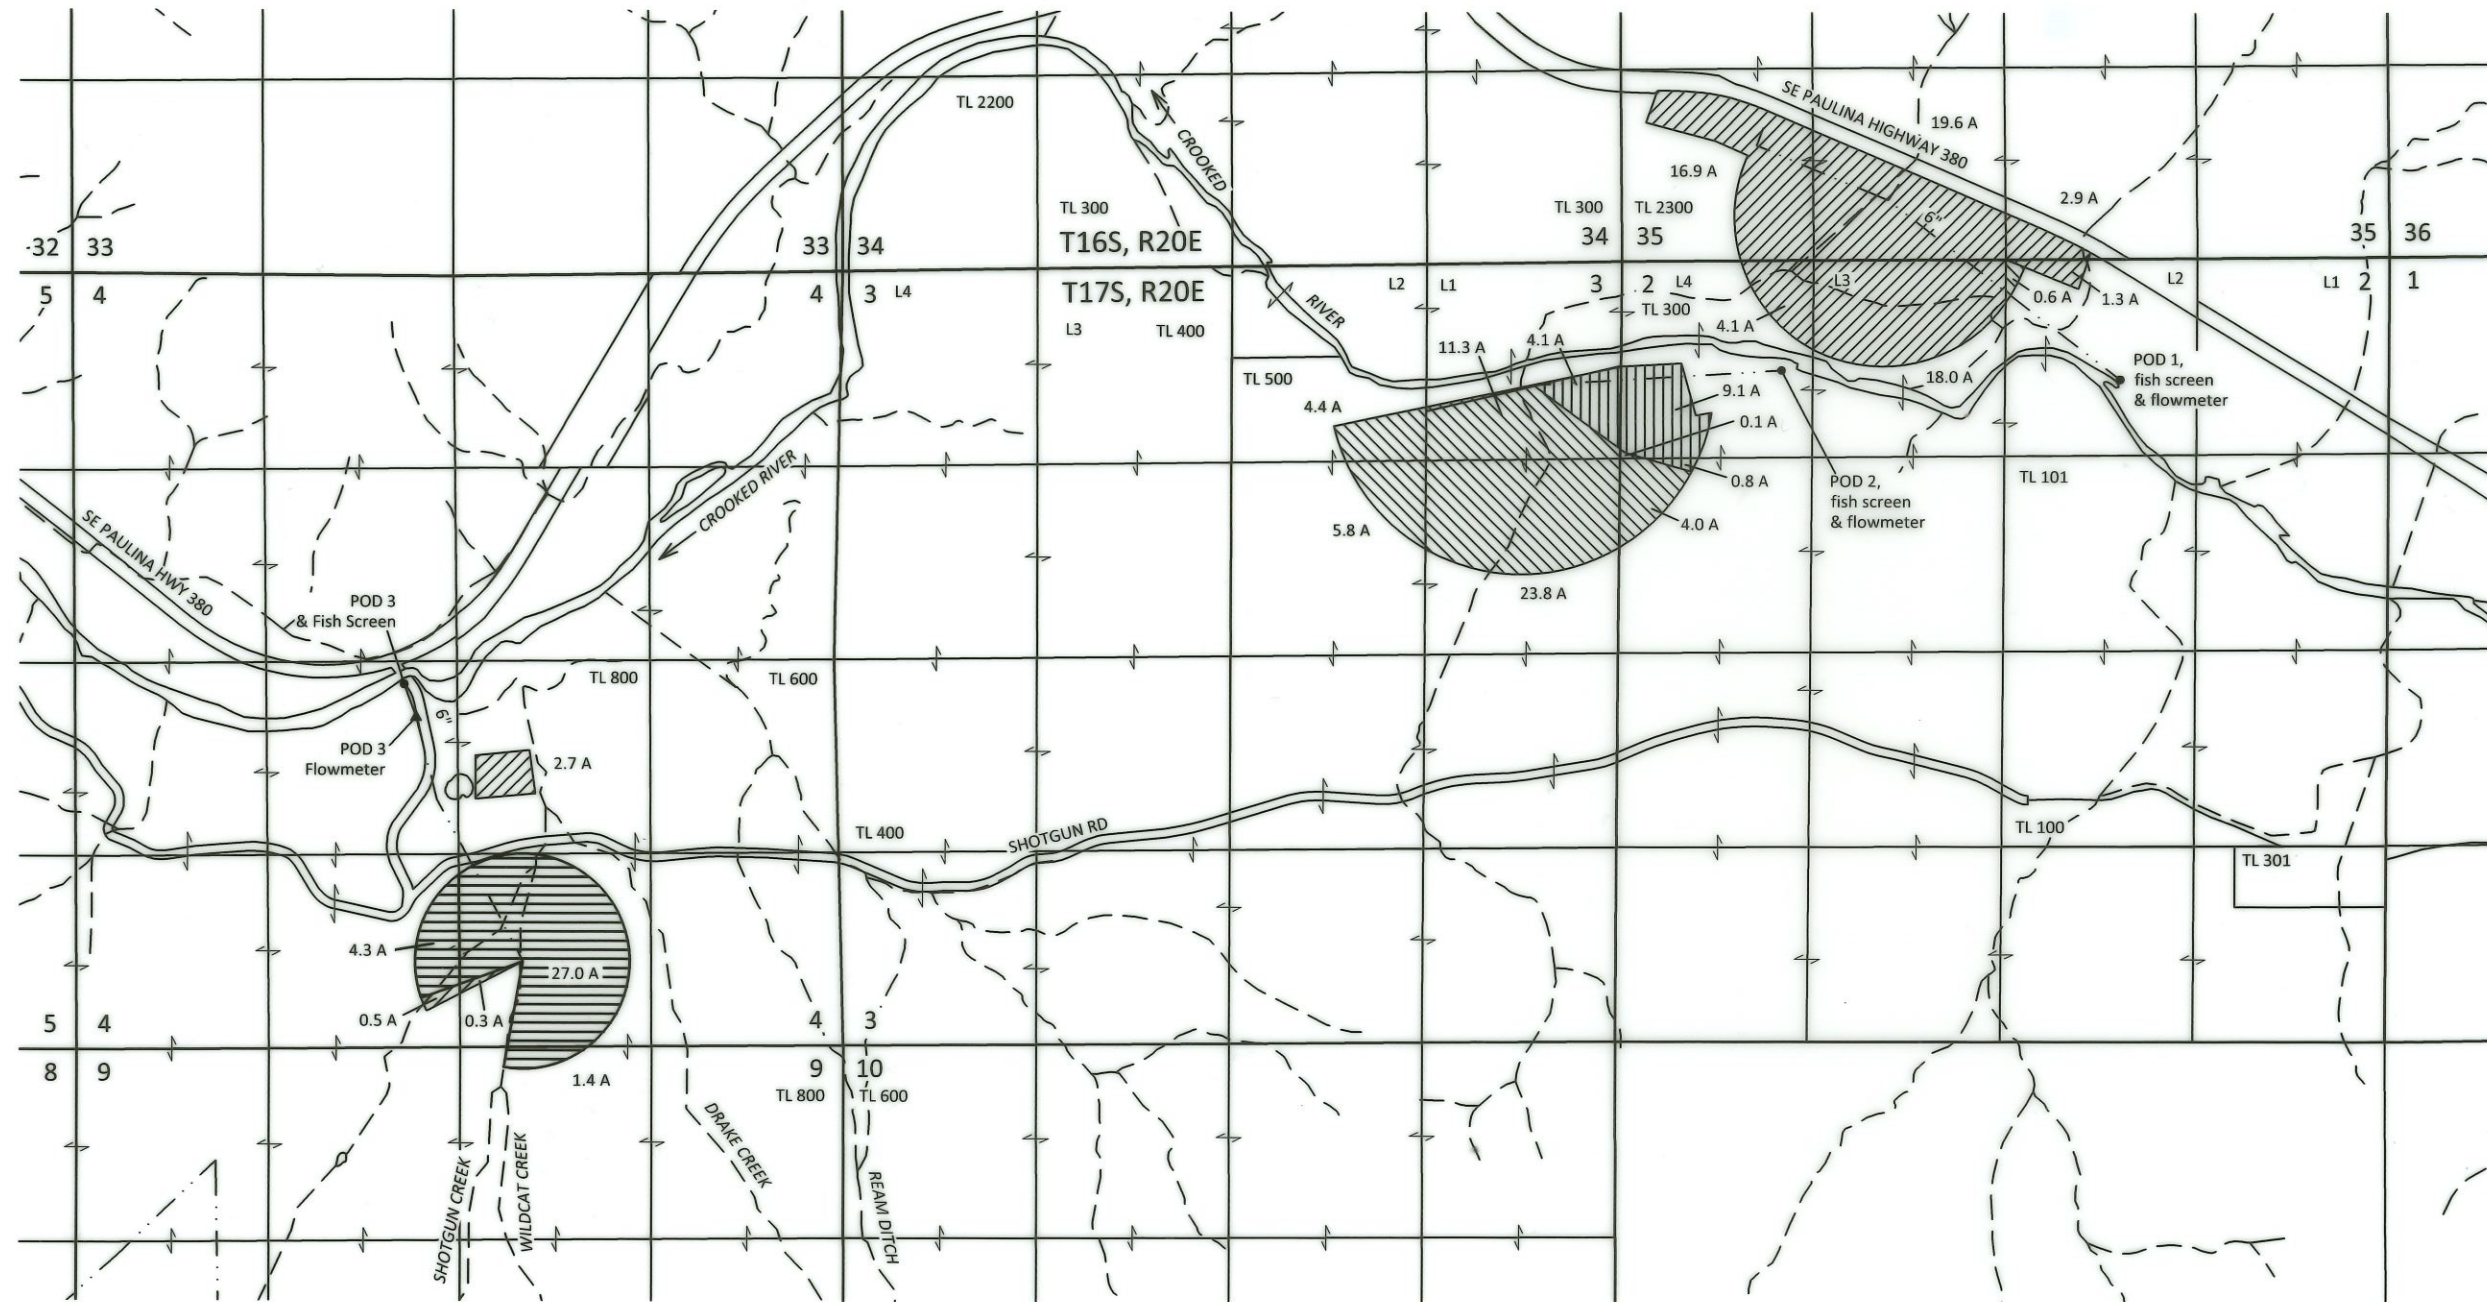






RECEIVED

MAY 25 2021

OWRD




EXPLANATION


- | | | | |
|---|---|---|--|
|  | PLACE OF USE - IRRIGATION - 66.3 ACRES
CANCELED CERTIFICATE 36936
PRIORITY: JANUARY 3, 1961 |  | PLACE OF USE - IRRIGATION - 32.7 ACRES
CANCELED CERTIFICATE 47488
PRIORITY: MARCH 16, 1961 |
|  | PLACE OF USE - IRRIGATION - 14.0 ACRES
CANCELED CERTIFICATE 47486
PRIORITY: MAY 27, 1916 |  | POINT OF DIVERSION (POD) |
|  | PLACE OF USE - IRRIGATION - 50.0 ACRES
CANCELED CERTIFICATE 47487
PRIORITY: MARCH 22, 1918 |  | FLOWMETER |
| | |  | MAINLINE (APPROXIMATE) |

POD 1 LOCATION: 840 FT S AND 1850 FT W FROM NE CORNER SECTION 2, T17S, R20E, W.M.
 POD 2 LOCATION: 750 FT S AND 1100 FT E FROM NW CORNER SECTION 2, T17S, R20E, W.M.
 POD 3 LOCATION: 140 FT S AND 2270 FT E FROM WEST 1/4 CORNER SECTION 4, T17S, R20E, W.M.

COBU MAP #1303

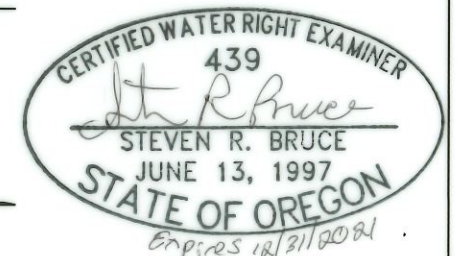

Site inspection conducted
 7/28/2020 and 4/21/2021

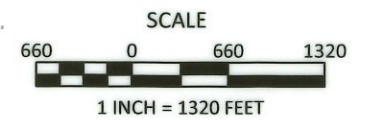

April 30, 2021

This map is not intended to provide legal
 dimensions or locations of property
 ownership lines

Figure 1

SKOOKUM
 WATER ASSOCIATES INC

1626 VICTORIAN WAY
 EUGENE, OR 97401
 (503) 319-8926

1303