
Claim of Beneficial Use A Water Right in the Name of The Coquille Indian Tribe Transfer T-12581 (Permit R-614)

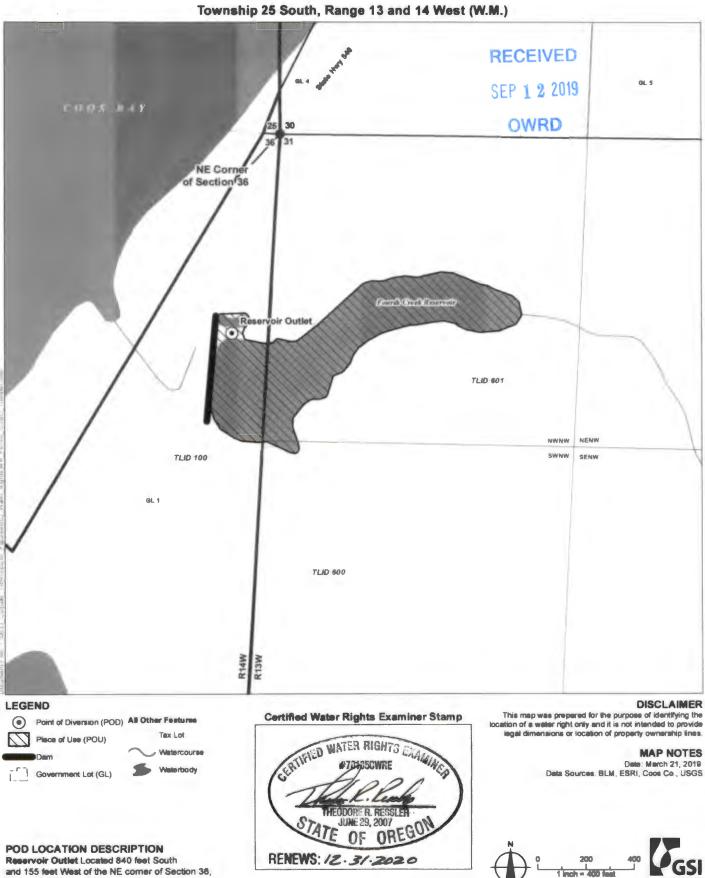

and 155 feet West of the NE comer of Section 38, Township 25 South, Range 14 West (W.M.)