

CLAIM OF BENEFICIAL USE MAP


SECTIONS 25 & 36, T3S, R1W, WM
 TAX LOTS 1000 & 200
 ALL WITHIN THE ANDERSON DLC #55
 CLACKAMAS COUNTY, OREGON

WATER RIGHT APPLICATION G-16134, PERMIT G-16020

PREPARED FOR:
 RUSSELLS NURSERY,
 22241 BOONES FERRY RD
 AURORA OR 97002



EXPIRES 06/30/2017

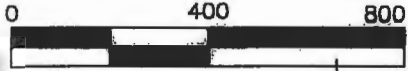

1 inch = 400 ft.

EAST

WELL LOCATIONS FROM SW CORNER OF SECTION 25
 WELL #1 290 FT EAST & 1200 FT NORTH
 WELL #2 280 FT NORTH & 1100 FT NORTH
 WELL #3 460 FT SOUTH & 630 FT EAST


NW CORNER
 ANDERSON DLC #55



LEGEND

- WELL WITH METER
- DLC LINE

- CERTIFICATE 38671
- PERMIT G-16020
- QTR QTR SECTION LINES 4" to 6" BURIED MAIN LINES

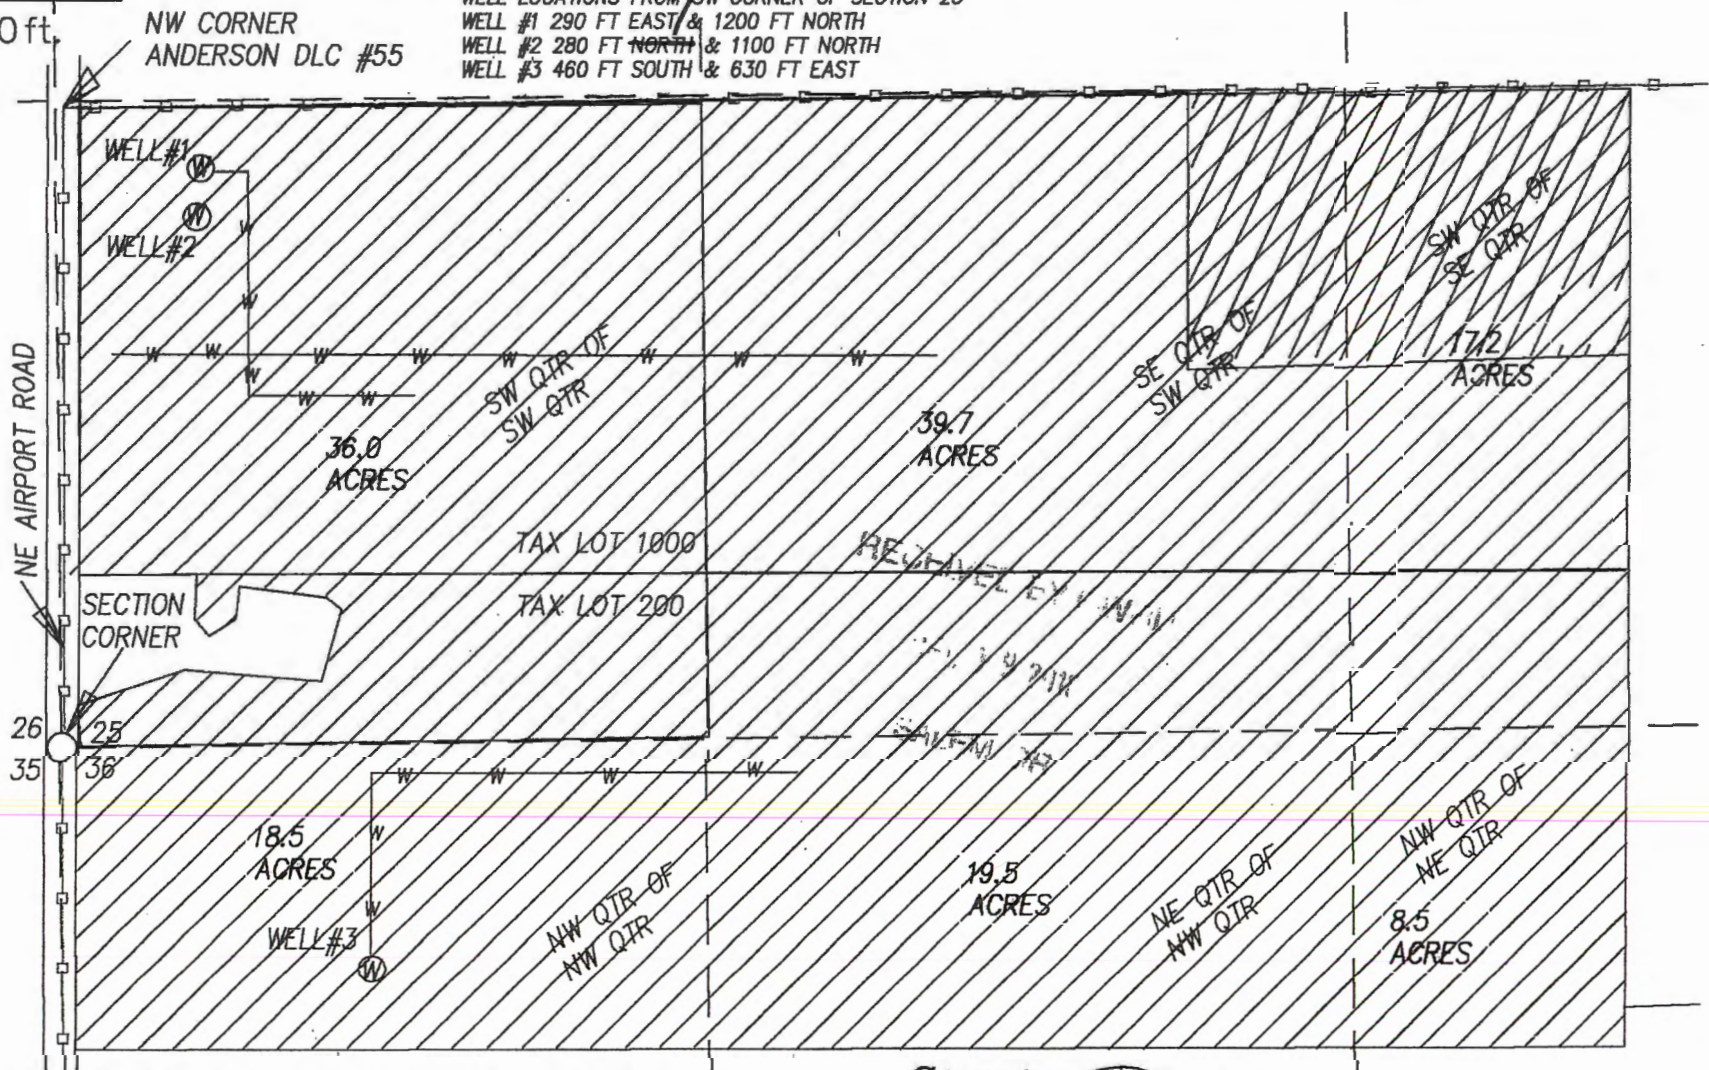

MAP BASES: CLACKAMAS COUNTY TAX MAP 3S R1W SEC. 25 & 36.
 2016 AERIAL PHOTO FROM GOOGLE EARTH

THIS MAP WAS PREPARED FOR THE PURPOSE OF IDENTIFYING THE LOCATION OF A WATER RIGHT ONLY AND IS NOT INTENDED TO PROVIDE LEGAL DIMENSIONS OR LOCATION OF PROPERTY OWNERSHIP LINES.



Project: 316-057
 By: JEFFREY KEE
 Date: DEC 6 2016