


Claim of Beneficial Use Permit G-8661, Application G-9261

RECEIVED

MAR 28 2018

OWRD

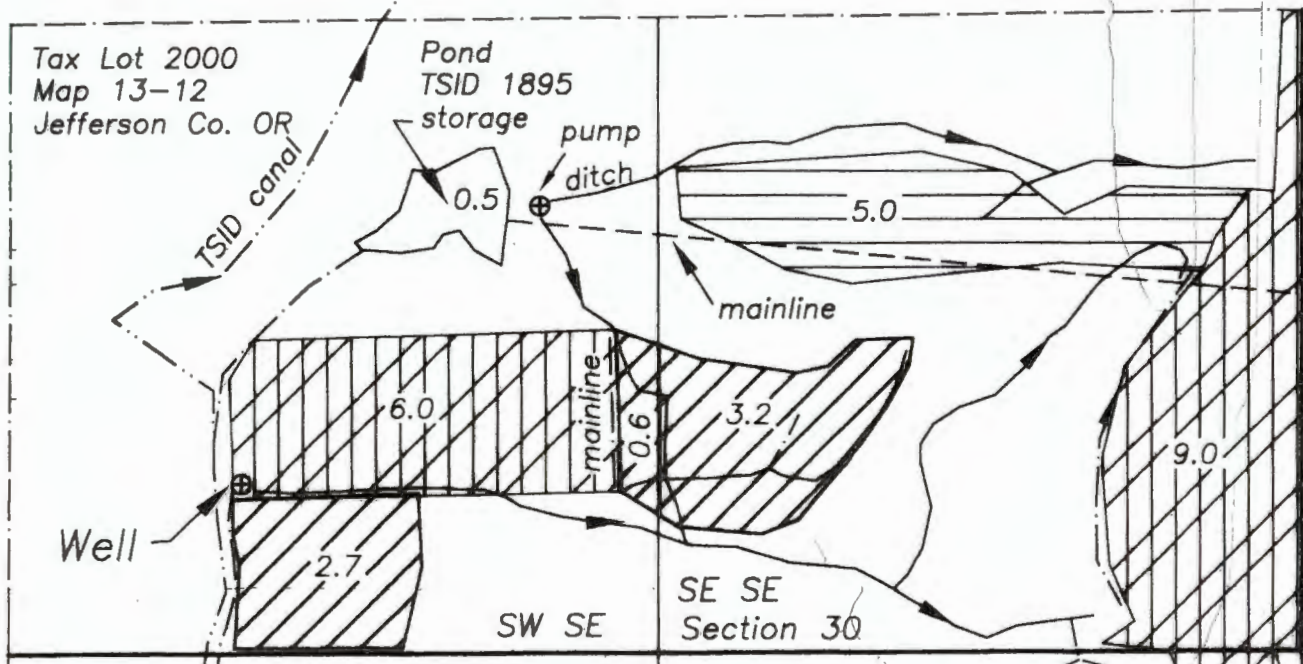

Renewal date: 6/30/2020

T13S R12E, W.M.
Jefferson County, Oregon

Well: 298' North and 1925' West from SE Corner
Section 30

- Tax lot boundary
- Three Sisters Irrigation District canal
- Ditch
- Mainline

- Water applied under Permit G-8661, priority date 6/1/1979
- Supplemental water applied under Permit G-8661, priority date 6/1/1979
- Certificate 74135, priority date 1895
- Certificate 74135, priority date 1904

This map is for the purpose of identifying the location of the water right. It is not intended to provide legal dimensions or locations of property ownership lines.


400 0 400 800 1200



Graphic Scale


Sheet 1 of 3

Claim of Beneficial Use
Permit G-8661, Application G-9261

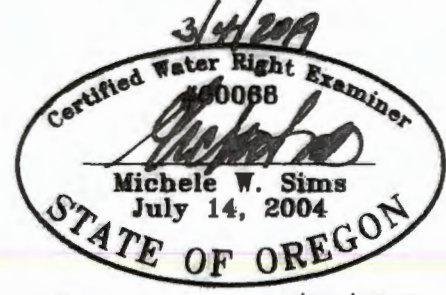

RECEIVED
MAR 28 2019
OWRD

Renewal date: 6/30/2020

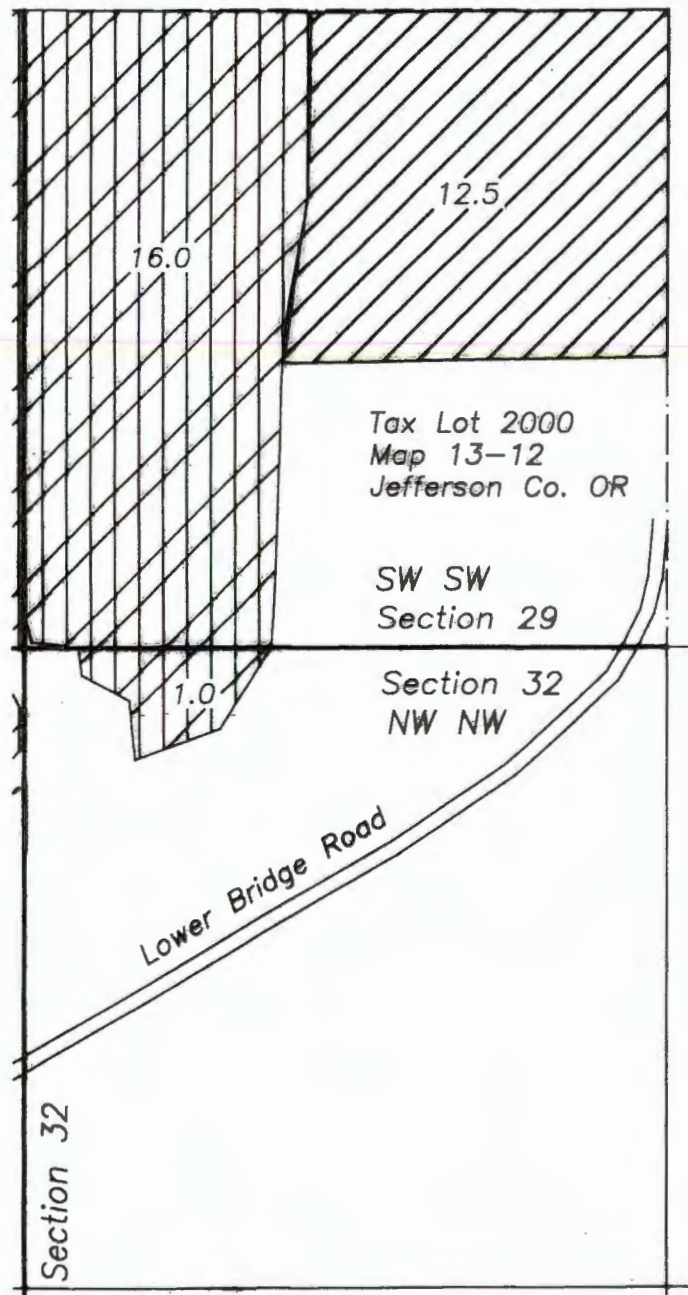

Tax Lot 2000
Map 13-12
Jefferson Co. OR




SW SW
Section 29

Section 32
NW NW

Lower Bridge Road


Section 32

T13S R12E, W.M.
Jefferson County, Oregon

- Tax lot boundary
-  Water applied under Permit G-8661, priority date 6/1/1979
-  Supplemental water applied under Permit G-8661, priority date 6/1/1979
-  Certificate 74135, priority date 1895

Well: 298' North and 1925' West from SE Corner Section 30

400 0 400 800 1200

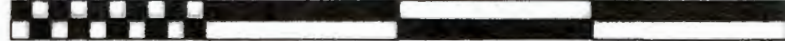




Graphic Scale

This map is for the purpose of identifying the location of the water right. It is not intended to provide legal dimensions or locations of property ownership lines.

Sheet 2 of 3

Claim of Beneficial Use
Permit G-8661, Application G-9261


RECEIVED
MAR 28 2019
OWRD

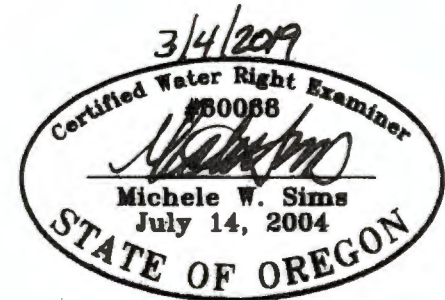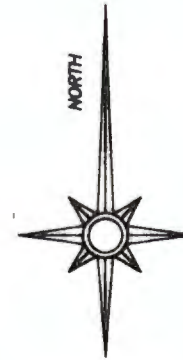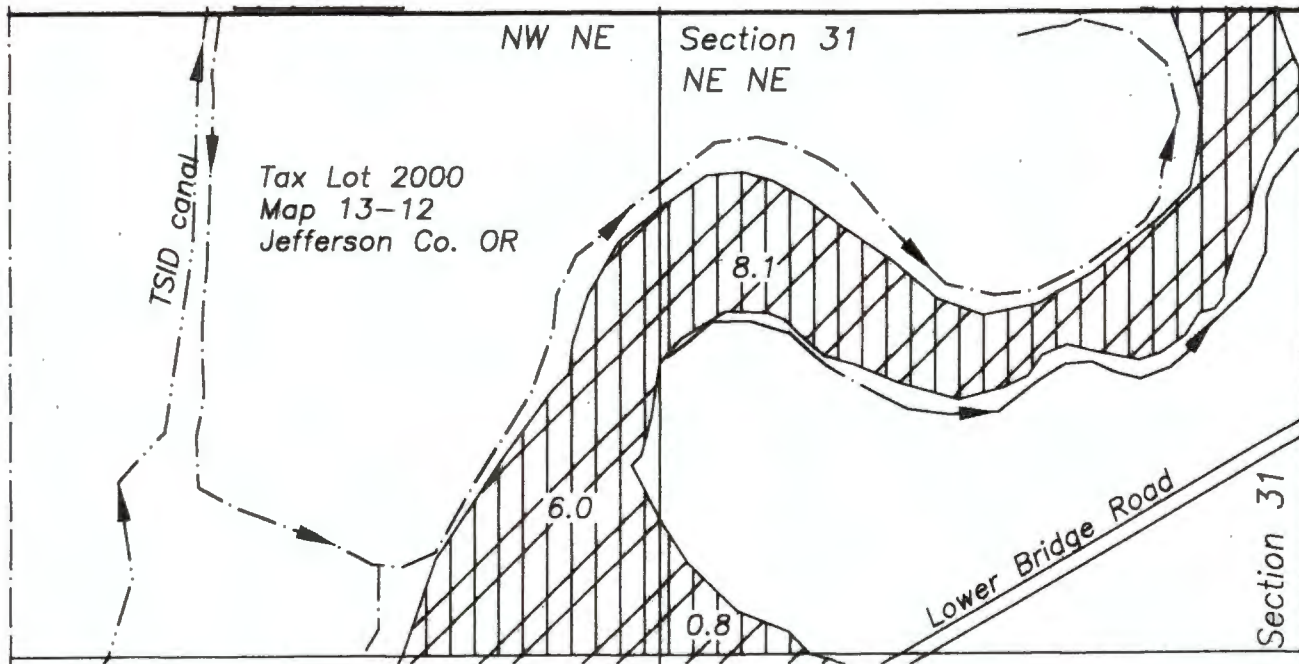

Renewal date: 6/30/2020

T13S R12E, W.M.
Jefferson County, Oregon

- Tax lot boundary
- Three Sisters Irrigation District canal
- Ditch
- Mainline

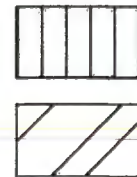

Supplemental water applied under
Permit G-8661, priority date
6/1/1979

Certificate 74135, priority date 1895

Well: 298' North and 1925' West from SE Corner
Section 30



Graphic Scale

This map is for the purpose of identifying the location of the water right. It is not intended to provide legal dimensions or locations of property ownership lines.

Sheet 3 of 3