

SCALE 1" = 400'

T.35S.,R.2W.,W.M.
Jackson County, Oregon
Tax Lot No. 352W 22 - 1801 & 1802
ROGUE RIVER BASIN

LEGEND

— * — * — = Fence
- • - • - = Irrigation Risers
(22 Total)




= IRRIGATED AREA,
PERMIT NO. G-13360



= IRRIGATED AREA,
PERMIT NO. G-13798

WELL COORDINATES


WELL No. 1, 70' NORTH AND 360'
EAST FROM THE SOUTH
1/4 COR. SECTION 22
WELL No. 2, 70' NORTH AND 630'
EAST FROM THE SOUTH
1/4 COR. SECTION 22
WELL No. 3, 2120' NORTH AND 300'
EAST FROM THE SOUTH
1/4 COR. SECTION 22
CWRE NOTE: TIE TO WELL
NO. 3 ON APPLICATION
WAS NOT CORRECT

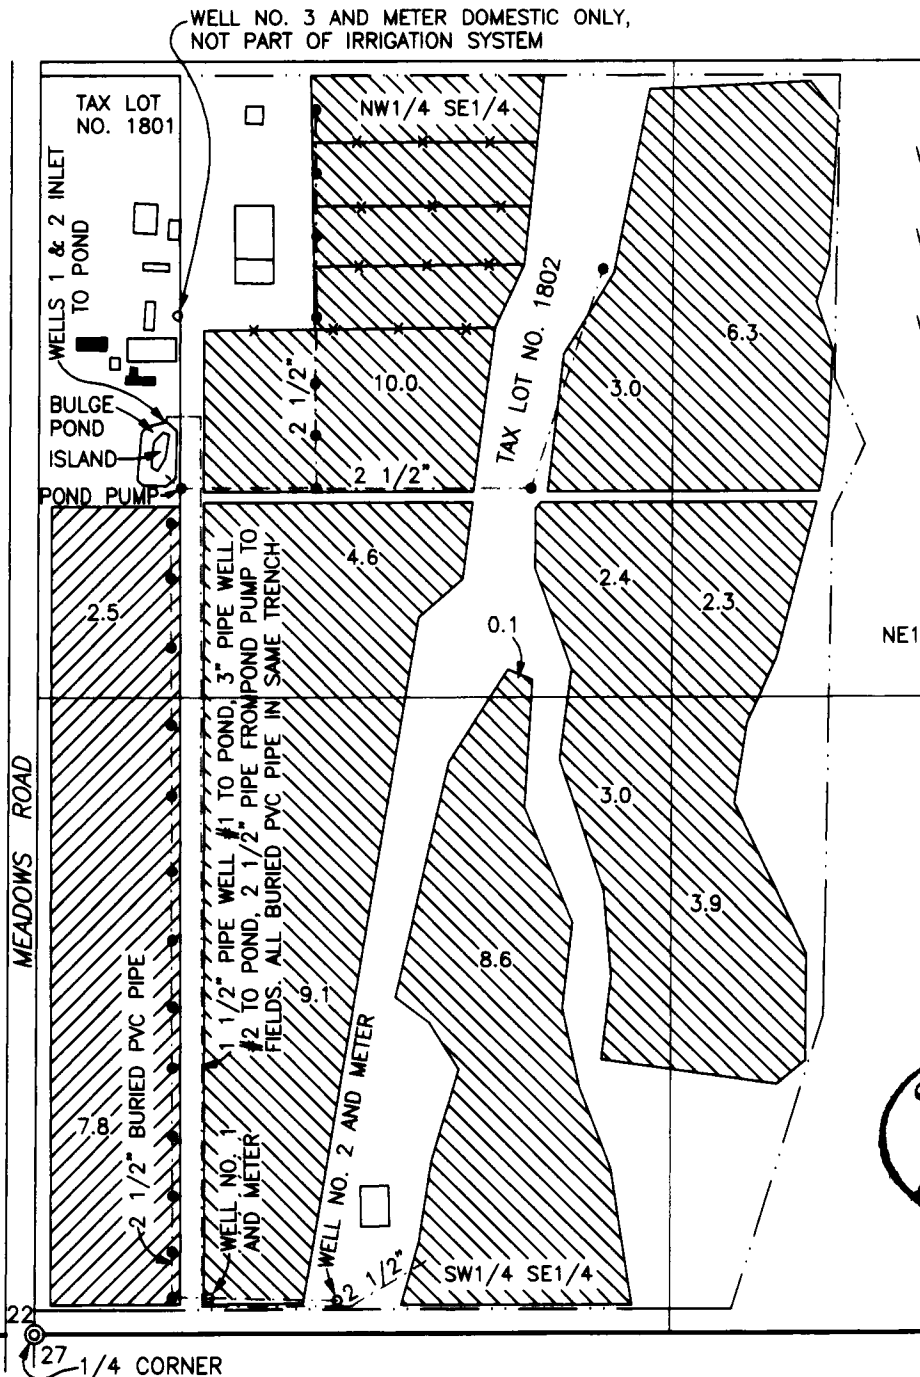

RECEIVED BY OWRD

DEC 22 2014

SALEM, OR

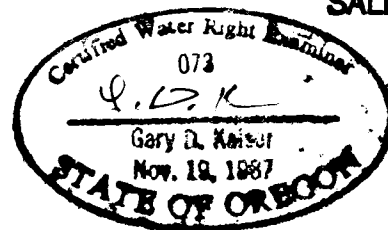

CLAIM OF BENEFICIAL USE MAP

APPLICATION No. G-14571, PERMIT
No. G-13360 AND APPLICATION No.
G-14950, PERMIT No. G-13798

FOR: JOSEPH BERTO
10984 MEADOWS ROAD
WHITE CITY, OREGON 97503

PREPARED BY:
GARY D. KAISER
19440 HWY. 62
EAGLE POINT, OR. 97524

DECEMBER 15, 2014

NOTE: MAP PREPARED FOR
WATER RIGHT PURPOSES ONLY,
NOT FOR PROPERTY BOUNDARY
LOCATIONS.